


NO.	NAMES	SCHEDULE OF PROPERTY				AREA	REMARKS
		QUANTY	GRANTEE	BEARING	DI. OF		
1
2
3
4
5
6
7
8
9
10
11
12
13
14
15
16
17
18
19
20
21
22
23
24
25
26
27
28
29
30

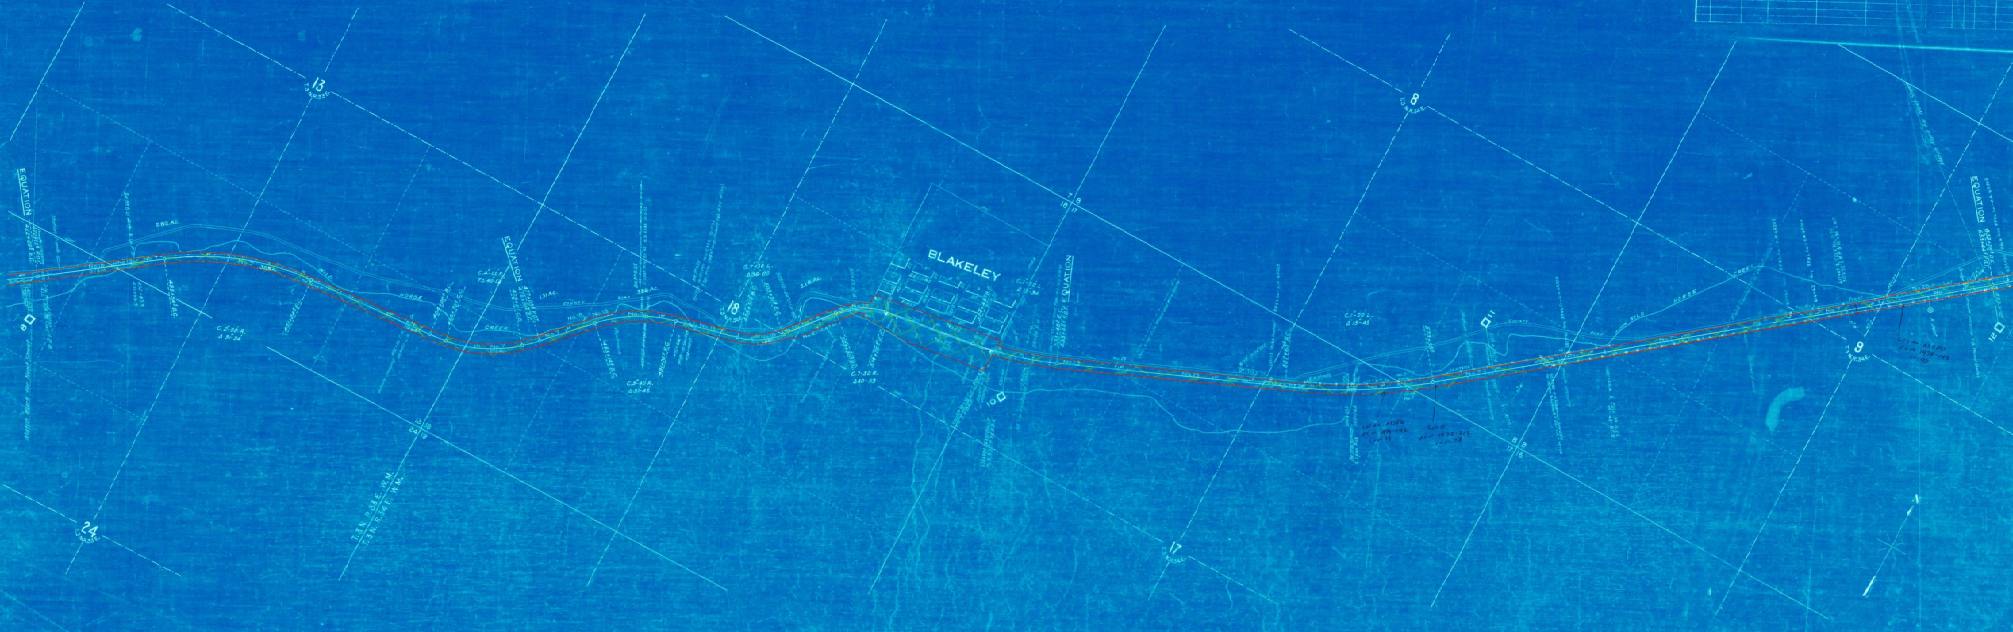

RIGHT-OF-WAY AND TRACK MAP
 BRANCH LINE
 PENDLETON TO ALTO

