Form 2085

B-19-3

50

N. P. R.

Wallula to Pendleton — **Right of Way Plat**

State of Oregon **County of** Umatilla

NW¼ NE¼ Section 11 **Township** 2 North **Range** 32 East **of** Will. **Meridian** NOV 1 1960

Scale 100 ft. = 1 Inch

Joins Sheet №49 **Note: Boundary of Right of Way denoted thus**

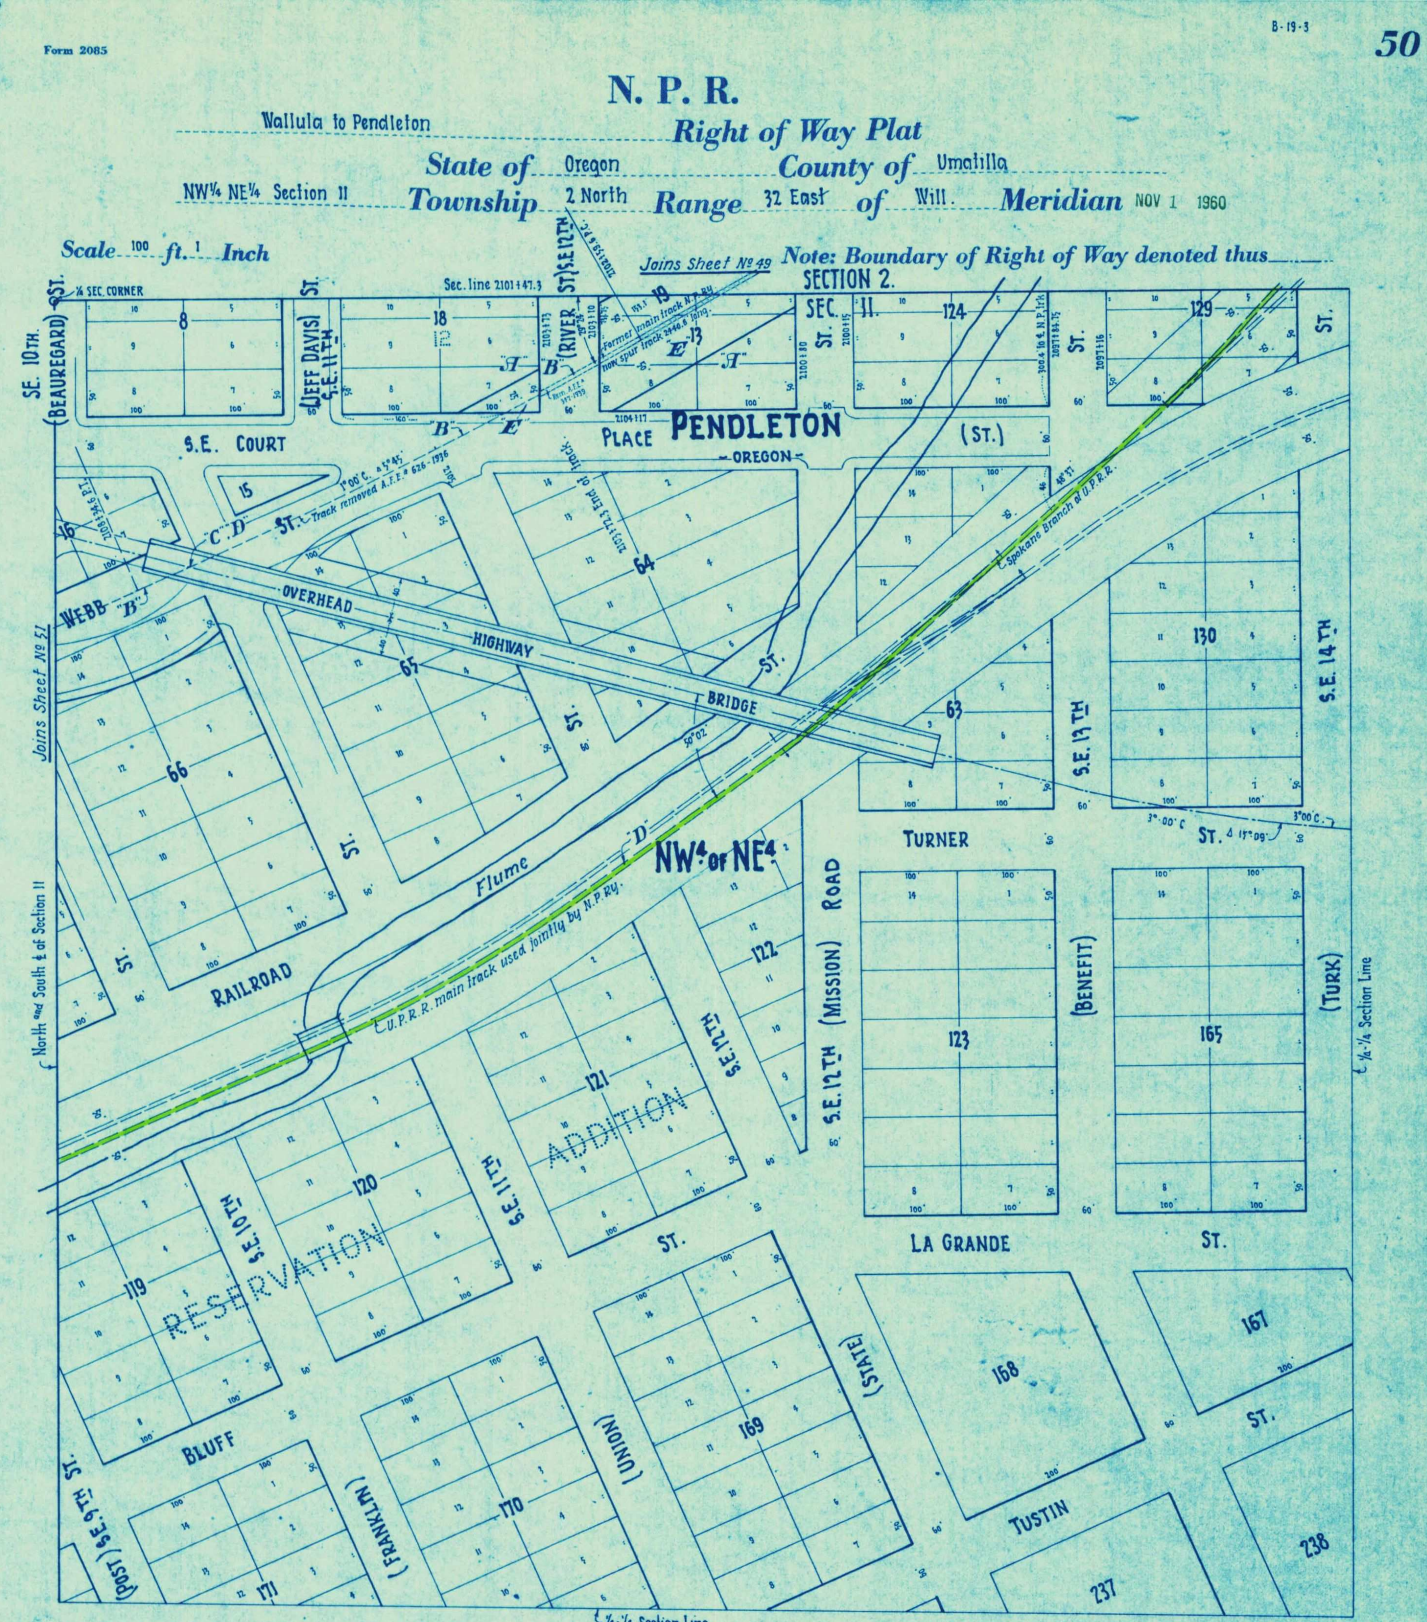

	Deed No.	Grantor	Grantee	Title	Acres	Date	When and Where Recorded	Brief Description	Cor. File	R/W Memo.
A	Title Memo 244	The N. P. Ry. Co. will claim title to R/w across Blocks 12 and 13 in Reservation Addition as shown					*Note: See Title Memo 808*	Feb. 9, 1915	3511	Ench File 1287
B	123	Town of Pendleton	O-W.T. R.R. Co.	Ord. # 192		May 2, 1889	*NOTE* Track removed.	Right to construct and maintain Ry. track across Court & River Strs. and upon and along Webb St.	20603	
C	126	Public Utilities Commission of Oregon	N.P. Ry. Co. et al.	Order		Dec. 20, 1935		Covering removal of N.P. tracks, construction of connections with O.W.R.& N. Co. and overhead highway viaduct.	do.	
D	129	O-W.R.& N. Co., U.P.R.R. Co., N.P. Ry. Co.	State of Oregon City of Pendleton	Contract		May 1, 1936		do.	do.	
E	Title Memo 808	*N.P. Ry. Co. claims no further interest in R/W across Blks 12 and 13 Reservation Addition - Trk removed A.F.E. 118-1948*						Sept. 21, 1948	3511	
F										
G										
H										
I										
J										
K										
L										
M										