Form 2085

B-19-3

52

N. P. R.

Wallula to Pendleton

Right of Way Plat

State of Oregon **County of** Umatilla

NW¼ NW¼ Section 11 **Township** 2 North **Range** 32 East **of** Will. **Meridian**

NOV 1 1960

Scale 100 ft. 1 Inch

Note: Boundary of Right of Way denoted thus

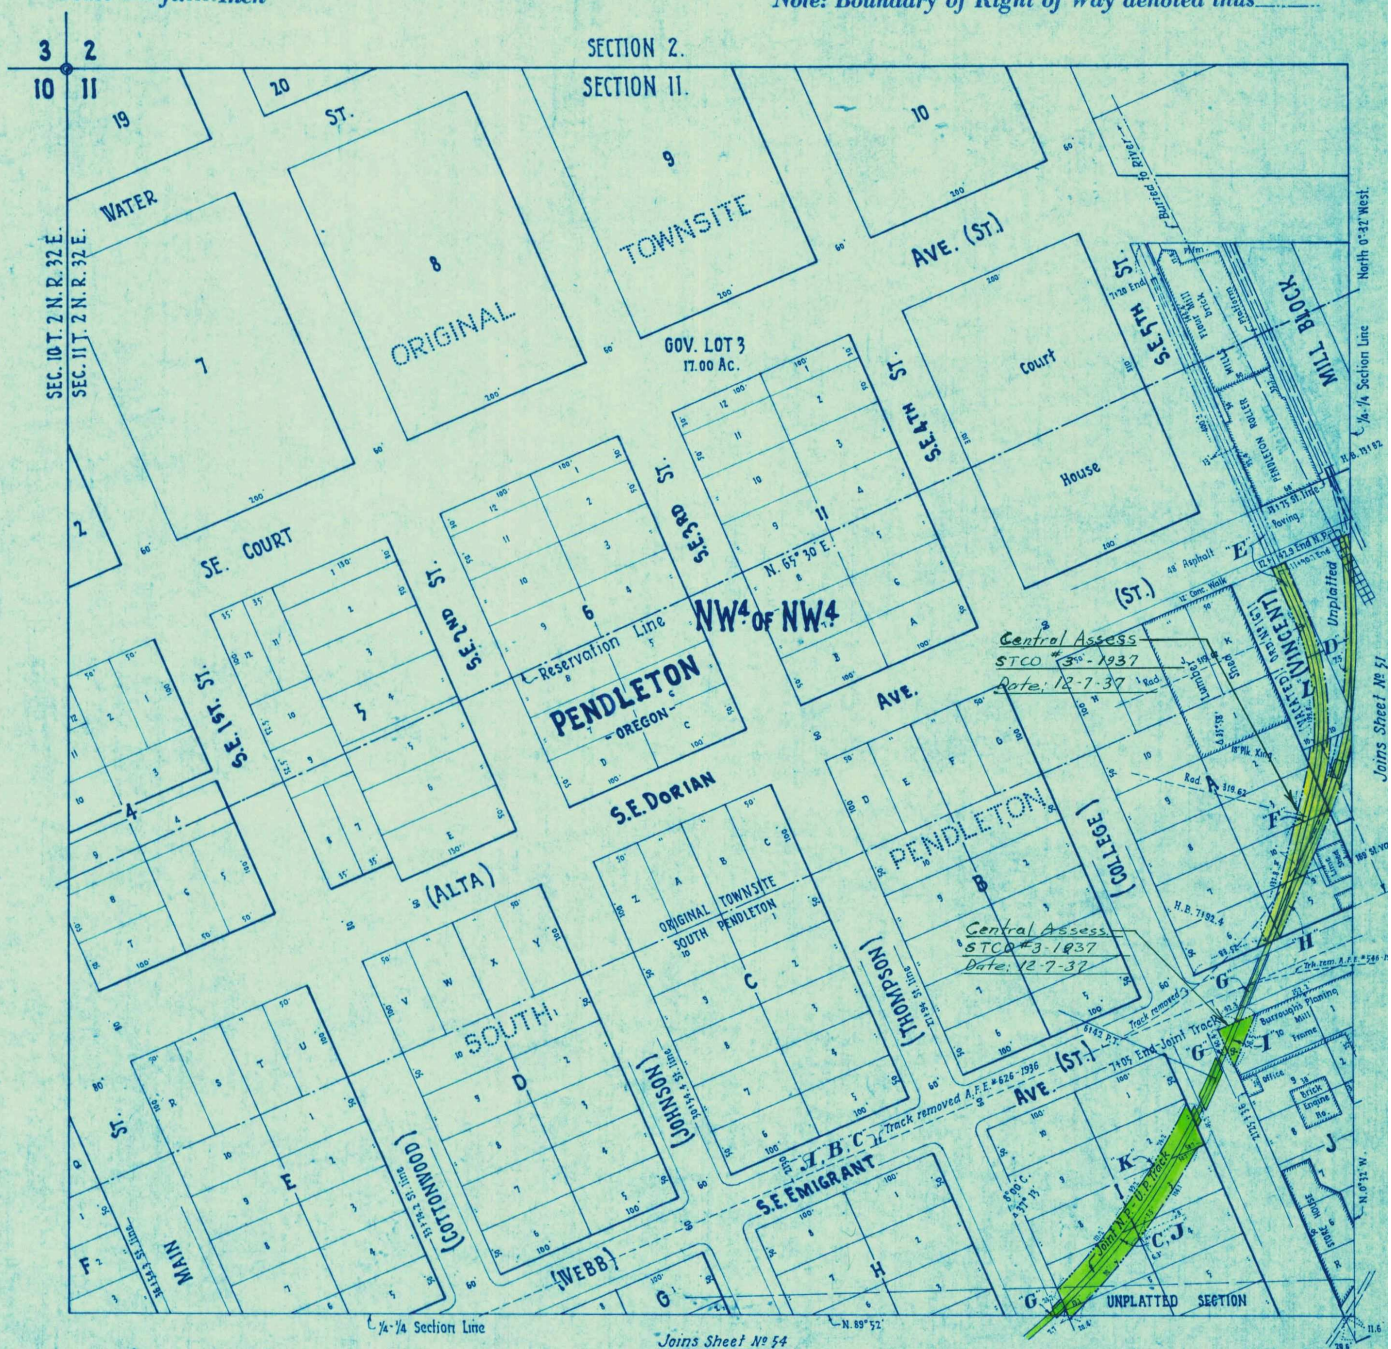

	Deed No.	Grantor	Grantee	Title	Acres	Date	When and Where Recorded	Brief Description	Cor. File	R/W Memo.
A	123	Town of Pendleton	O.&W.T.R.R.Co.	Ord.# 192		May 2, 1889	*NOTE* Track removed. A.F.E. 626-36	Grants right to construct and maintain Ry. track in Webb St.	20603	
B	126	Public Utilities Commission of Oregon	N.P.Ry.Co. et.al.	Order		Dec. 20. 1935		Covering removal of track in Webb St.	do.	
C	129	O.W.R.&N.Co., U.P.R.R.Co., N.P.Ry.Co.	State of Oregon City of Pendleton	Contract		May 1. 1936		Covering removal of track in Webb St. and joint use of U.P. track.	do.	
D	Title Memo 627	The Ry. Co. claims by adverse possession a 15' R/w for spur track serving the Western Grain & Milling Co.							May 20. 1932	20084
E	131	City of Pendleton	N.P.Ry.Co.	Ord.# 1669		Dec. 4. 1936	(Vol. 7 of this is removed A.F.E. 626-36) (Part of 15' strip reserved by this Ord. lying west of said berry line of Alta St. (now S.E. Dorian Ave.) relinquished to City (Deed 151-A) R/W Memo 134/51)	Right to construct and maintain spur track in Vincent St. on a 13' strip	do.	7/37
F	132	Tum-A-Lum Lumber Co.	do.	Easement		Dec. 5. 1936	Dec. 14. 1936 Book 151 Deeds P. 349	20' R/w for spur track across Blk. A and vacated Vincent St., South Pendleton	do.	8/37
G	134	City of Pendleton	N.P.Ry.Co., O.W.R.&N Co. & U.P.R.R.Co.	Ord.# 1662		Apr. 24. 1936		Right to construct track in and across Railroad, Thompson, College and Webb Strs. Term 25 years.	20603	31/37
H	135	Tum-A-Lum Lumber Co.	N.P.Ry.Co.	Easement		Aug. 6. 1936	Sept. 18. 1936 Book 151 Deeds P. 62	18' R/w for spur track across Lots 4, 5 & 6 Blk. A South Pendleton.	20084	36/37
I	136	do.	N.P.Ry.Co. & O.W.R.&N.Co.	do.		do.	Sept. 18. 1936 Book 151 Deeds P. 61	Triangular tract in Lot 10 in Blk. J, South Pendleton.	do.	37/37
J	138	State of Oregon	do.	B.&S. Deed		Nov. 21. 1939	Jan. 26. 1940 Vol. 160 Deeds P. 9	Spur trk. across Blk. I, South Pendleton	do.	115/39
K	139	do.	do.	War. Deed		do.	Jan. 26. 1940 Vol. 160 Deeds P. 10	R/w for joint trk. across Blk. I, S. Pendleton	do.	do.
L	143	City of Pendleton	The Public	Ord.# 1671		Feb. 5. 1937		Vacates part of Vincent St. (now S.E. 5th St.) lying betw. the city line of 1916 & Vincent & Dorian Ave. (and the only line of Webb St. (now S.E. Emigrant Ave.) not heretofore vacated.	20603	49/48
M										