UMATILLA INDIAN RESERVATION

Township No. 1 South, Range No. 33 East Willamette Meridian in Oregon.

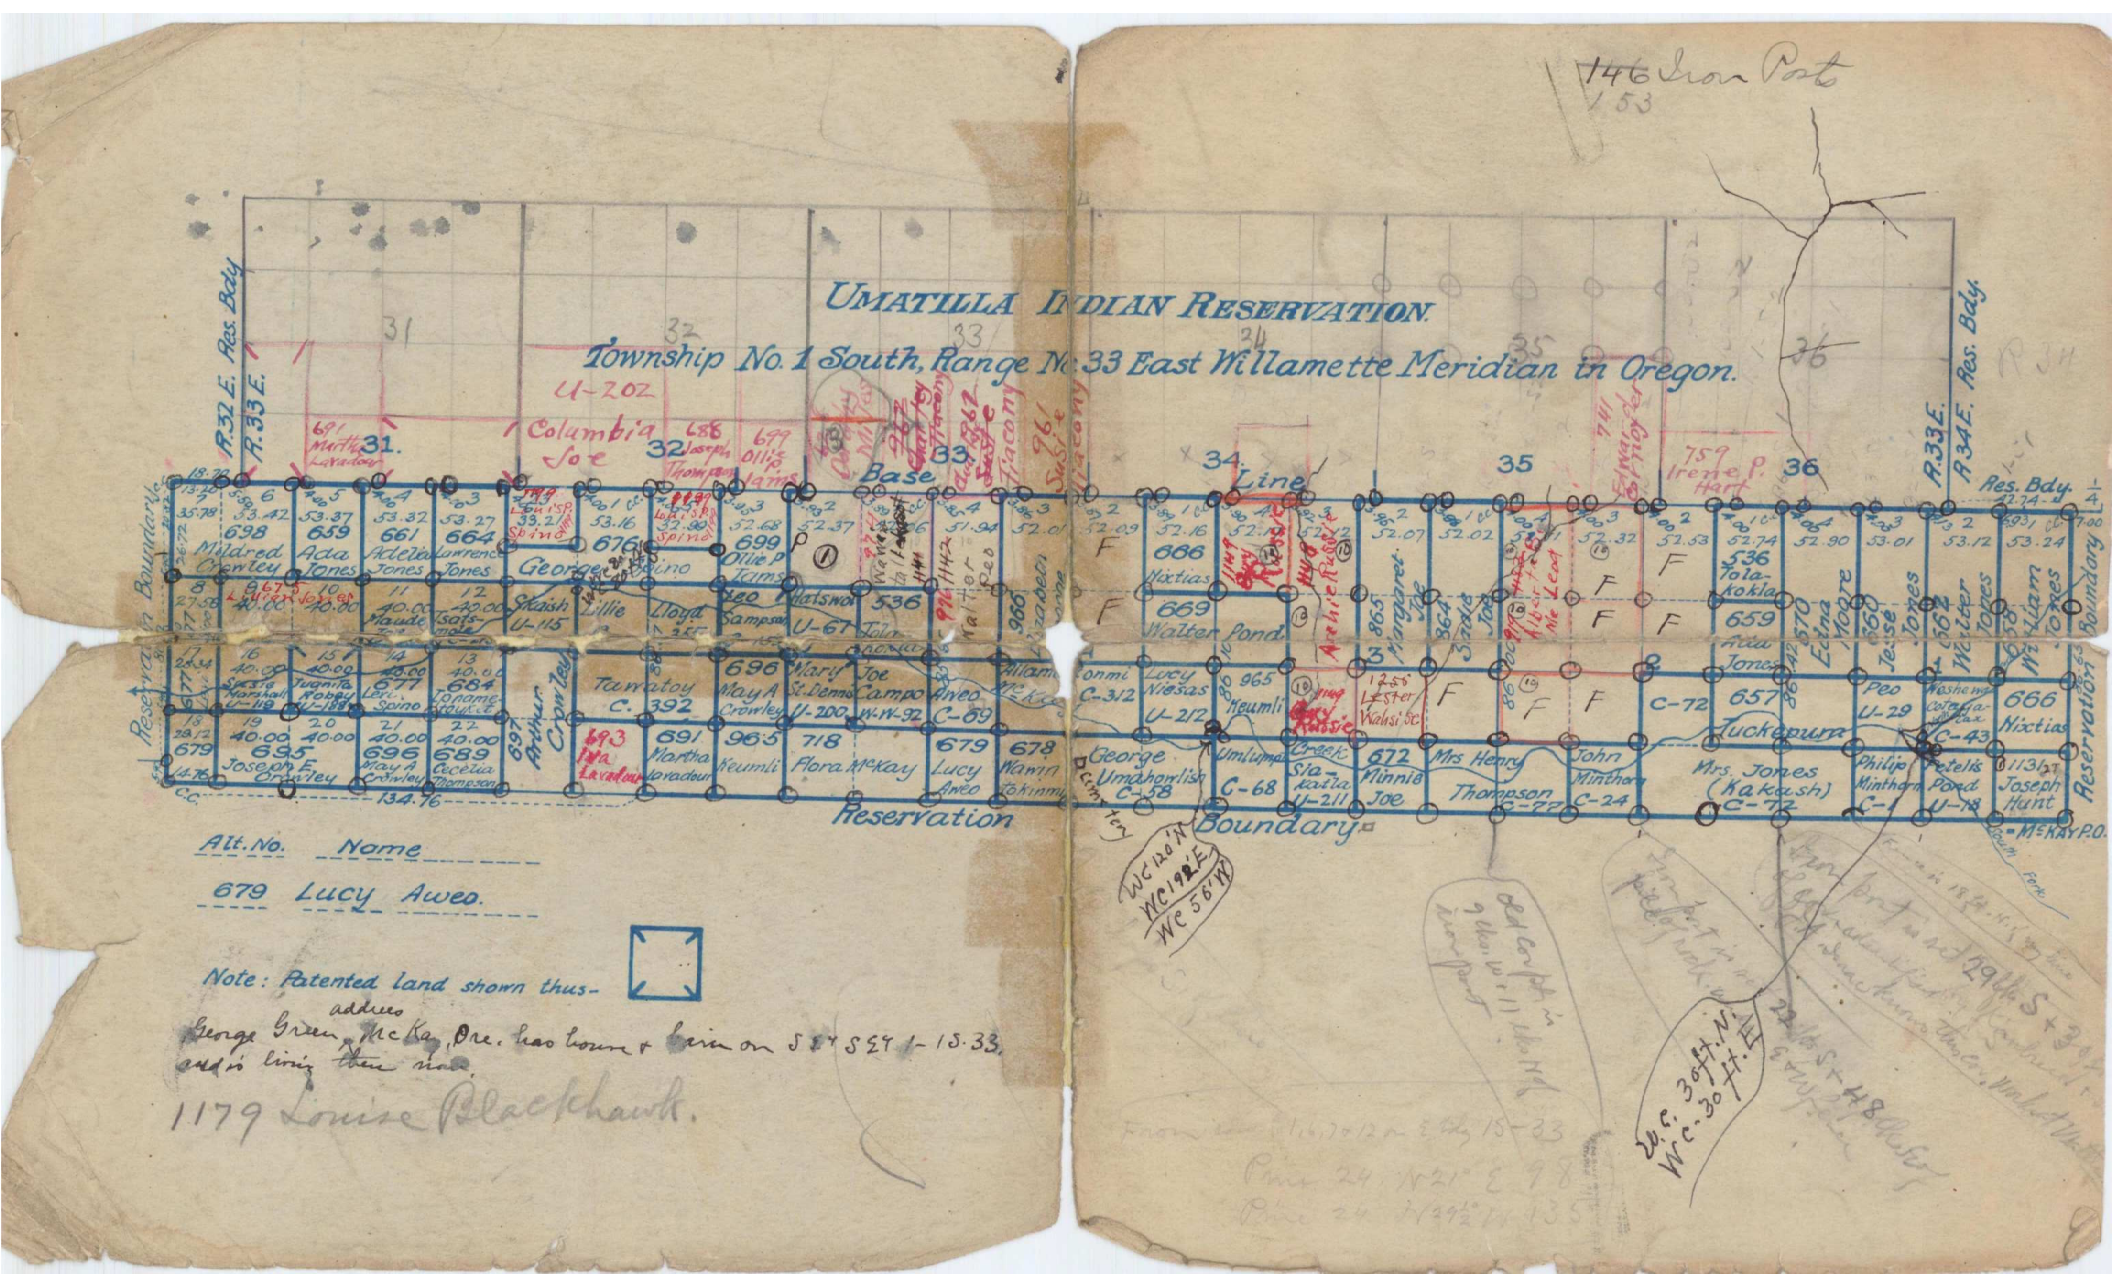
R.32 E. Res. Bdy.
R.33 E.
R.33 E.
R.34 E. Res. Bdy.
Base Line
Reservation Boundary
Reservation Boundary
Columbia
Joe
Arthur Crowley
Tamatoy C. 392
Lucy Aweo
Walter Pond
Mrs Jones (Kakaush) C-72
Tuckepuna
Mrs Henry Thompson C-77
John Minthorn C-24
Philip Minthorn C-1
Joseph Hunt
McKAY P.O.
George Umahorlish C-58
Umatilla Creek
Sia-tatia U-211
Minnie Joe
Flora McKay
Mary St. Denis U-200
Joe Campo W.W.-92
Lloyd Sampson
Watsnoi U-67
Lillie
Shaish U-115
Louis Spino
Ollie P. Tamo
Louis Spino
