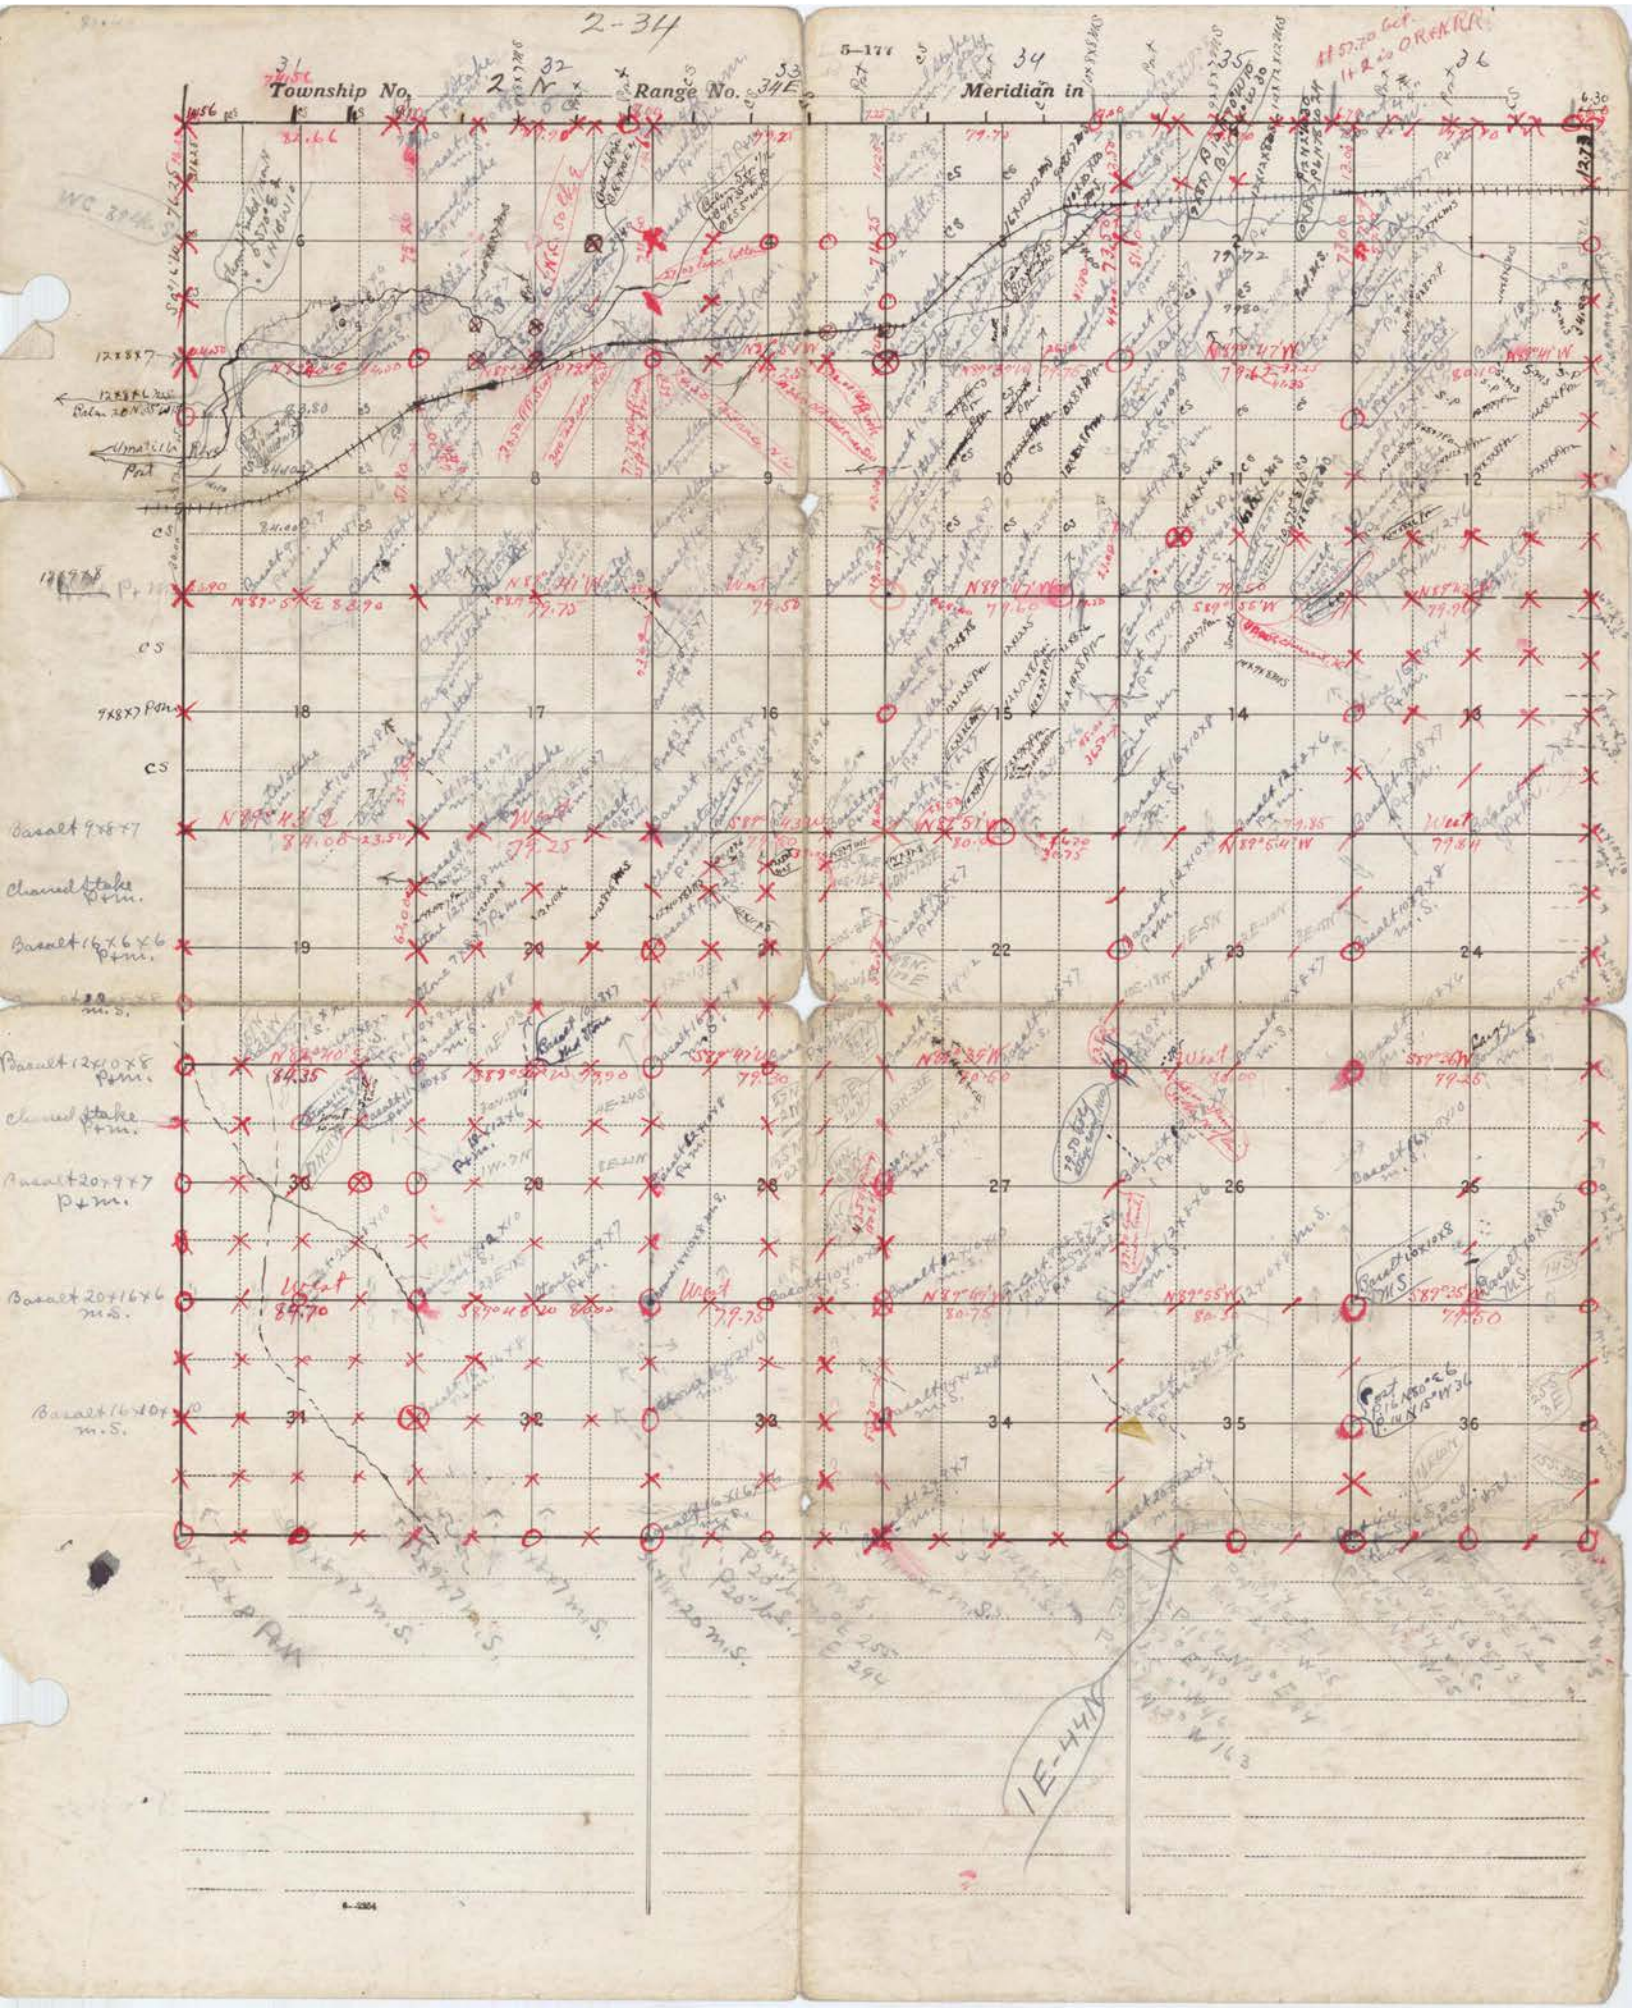
2-34
Township No. 2 N.
Meridian in
Umatilla Pmt
Basalt 9x8x7 P+m.
Channel Stake P+m.
Basalt 16x6x6 P+m.
Basalt 12x10x8 P+m.
Channel Stake P+m.
Basalt 20x9x7 P+m.
Basalt 20x16x6 m.s.
Basalt 16x10x7 m.s.
1E-4N