5—177

Township No. 2 N. Range No. _____ Meridian in 35 E.

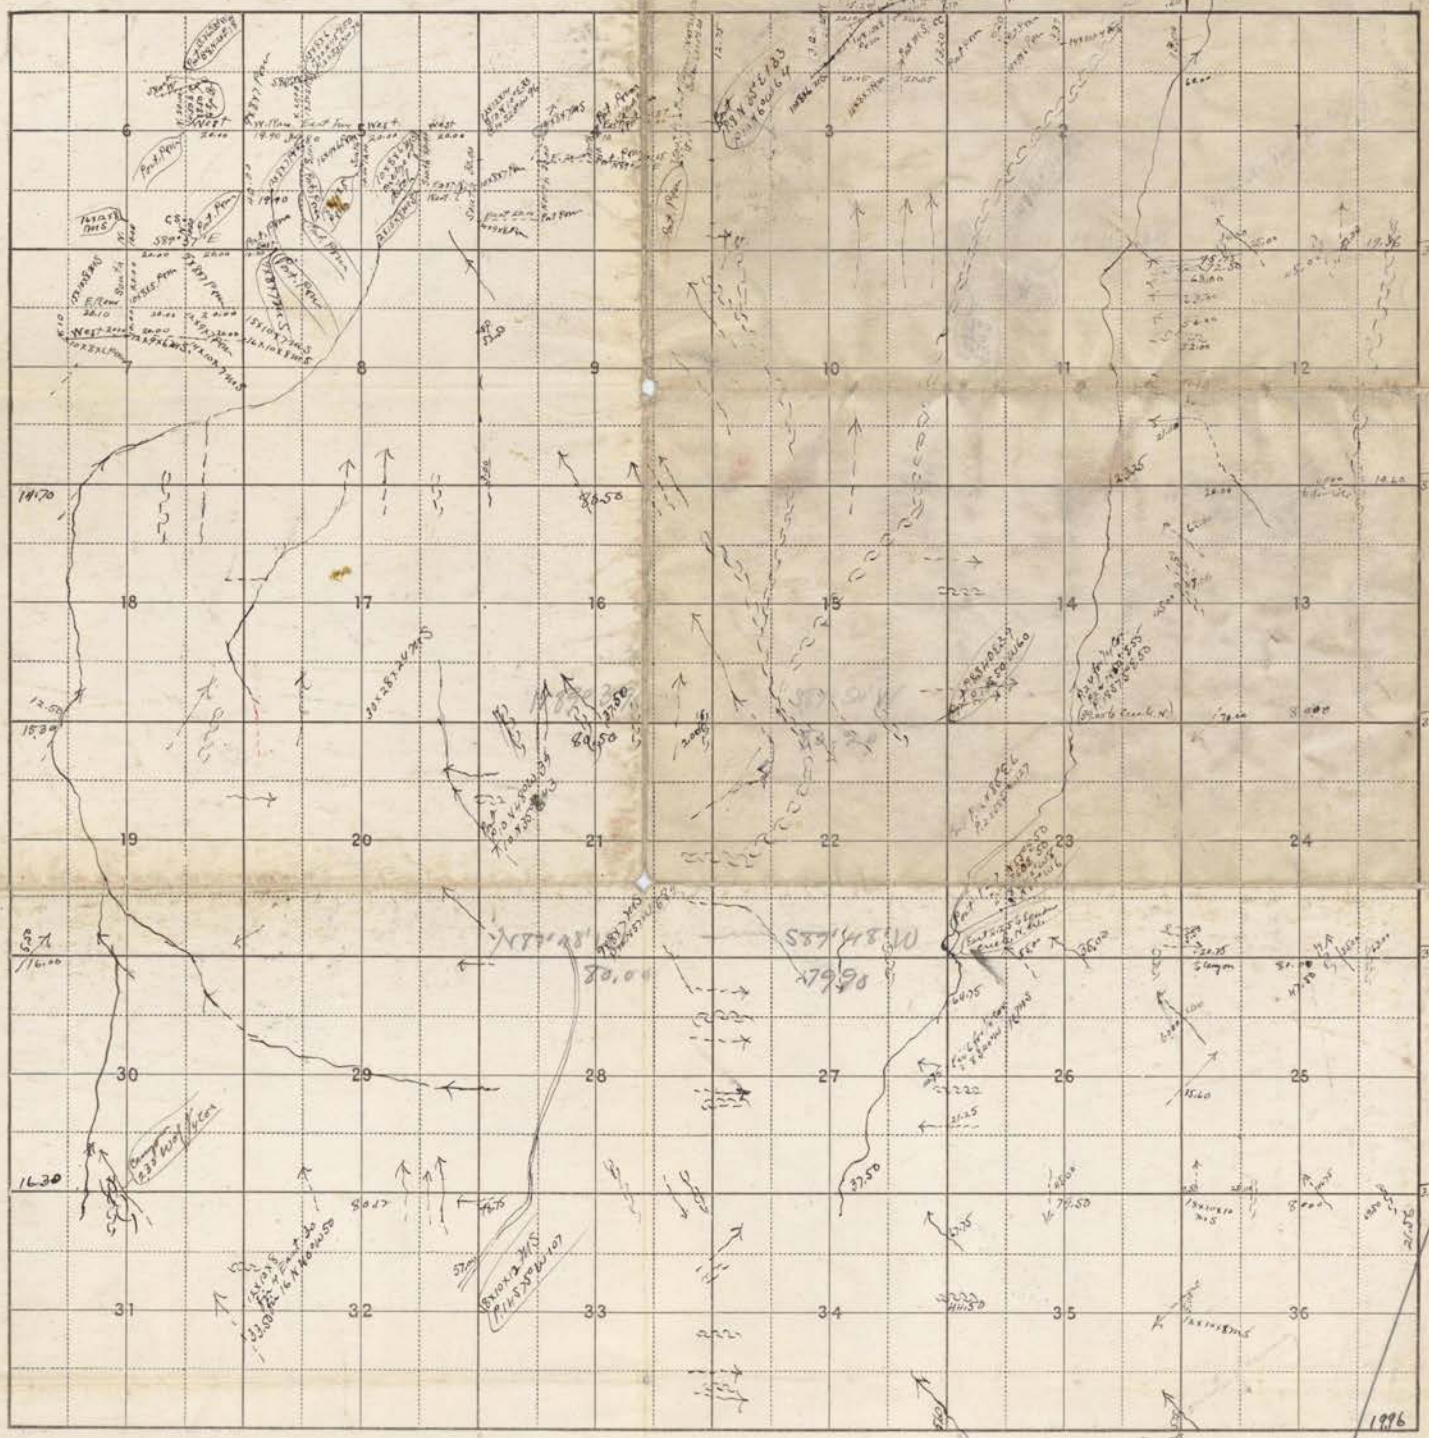

(conclusion of topography)