T. 2 N., R. 36 E., W.M.

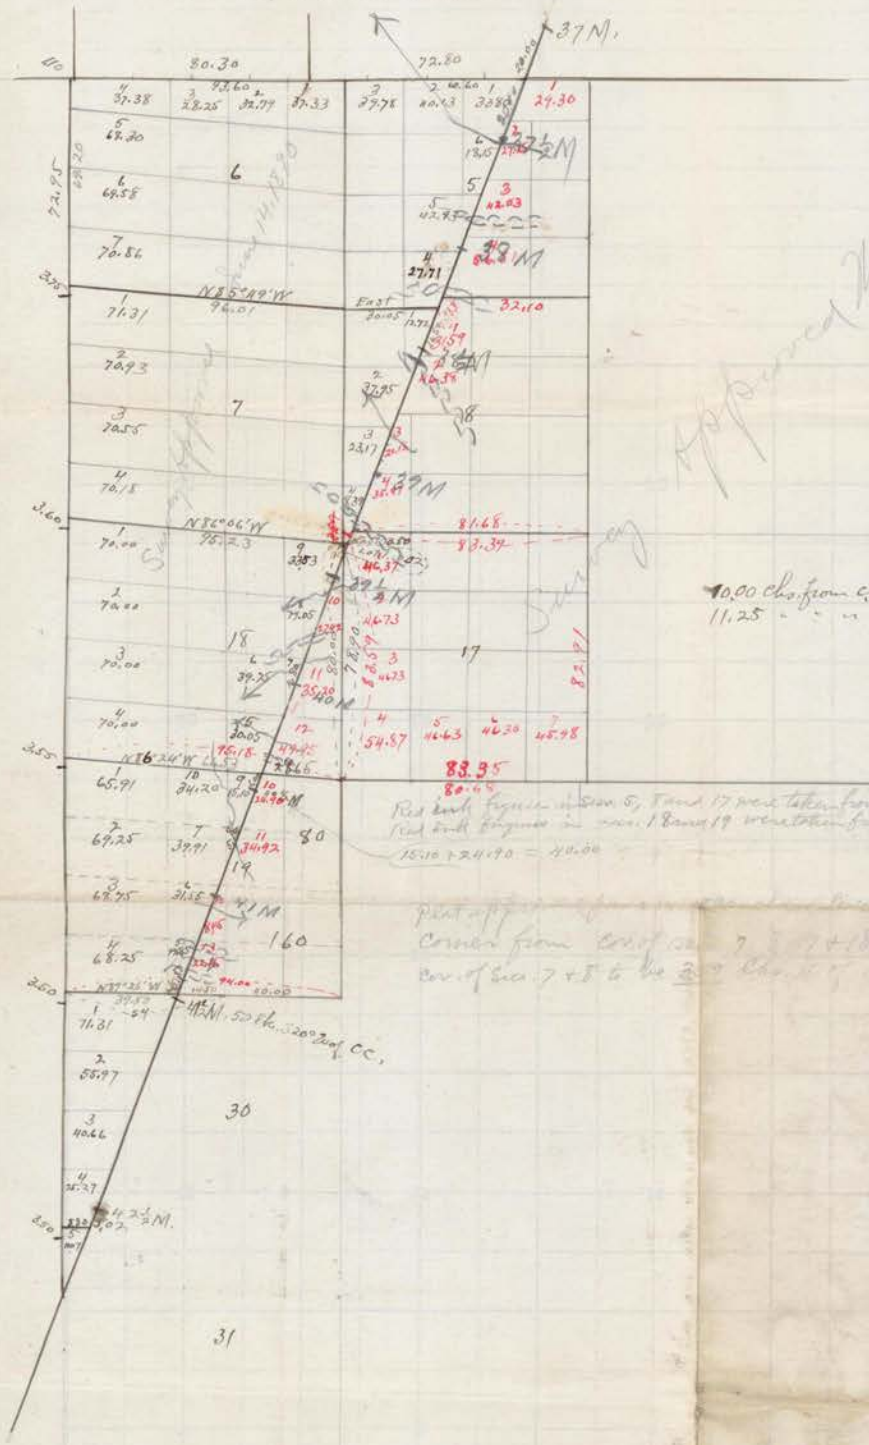

Survey Approved Mar. 4, 1903.

10.00 chs. from c.c. of ~~sec.~~, 17 + 18 to 39½ M. Cor.
11.25 " " " " 8 + 17 " " "

Red ink figures in Secs. 5, 7 and 17 were taken from plat approved Mar. 4, 1903.
Red ink figures in secs. 18 and 19 were taken from plat having notation "Rec'd with Sur. Gen'l letter Oct. 23, 1890" Div. 8
15.10 + 24.90 = 40.00

Plat approved [illegible] bet. secs. 8 + 17 to run east 50 links to a closing corner from cor. of secs. 7, 8, 17 + 18, while [illegible] Mar. 4, 1903 [illegible] cor. of Secs. 7 + 8 to be 39 chs. [illegible]

S20° W on 41st mile
39.00 O R + N. N + S.
40 Set Post for ½ Mile Cor. Fir 16 N 40° W 114 chs. M.S.
59.25 Meacham Creek, N.

2-36

2-36