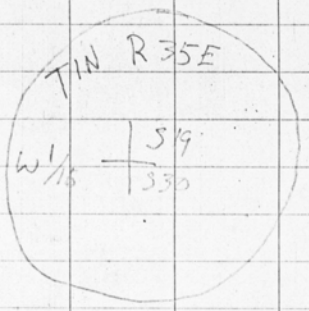
T1N R35E
W1/16
S 19
330

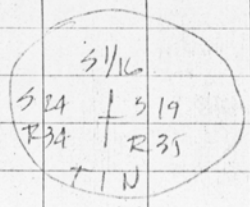
S1/16
S 24
T 3 19
R 34
R 35
T 1N

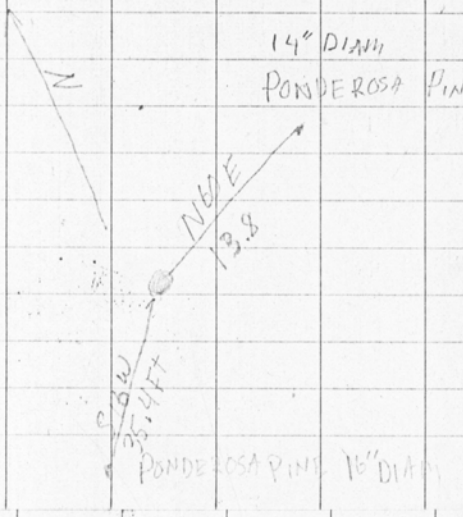
N
14" DIAM
PONDEROSA PINE
N61E
33.8
S 84 W
35.4 FT
PONDEROSA PINE 16" DIAM

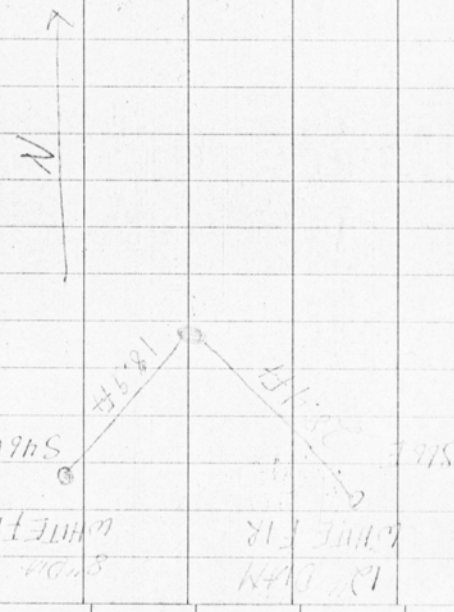
N
184 FT
S 46 E
WHITE FIR
18" DIAM

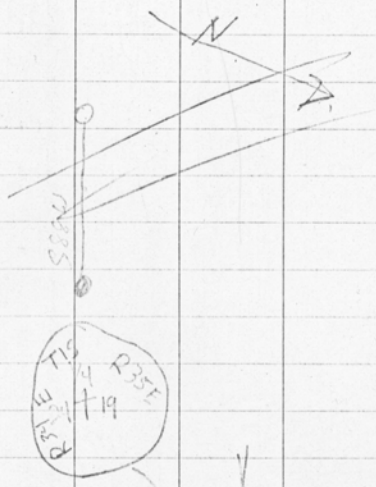
N
S 60 W
T1S
R35E
S 19

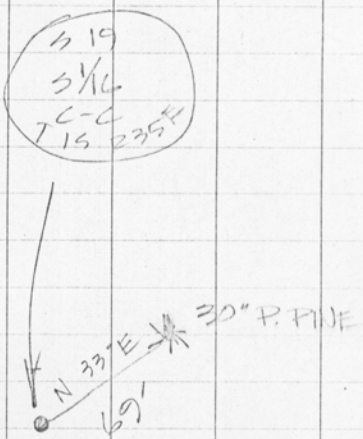
S 19
S1/16
C-C
T 1S
235 FT
N 33° E
30" P. PINE
69'

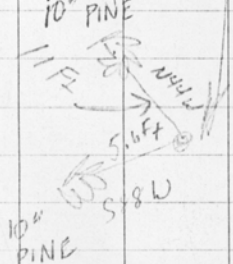
P.
10" PINE
11 FT
S 46 E
5.6 FT
S 8 W

10" P. PINE