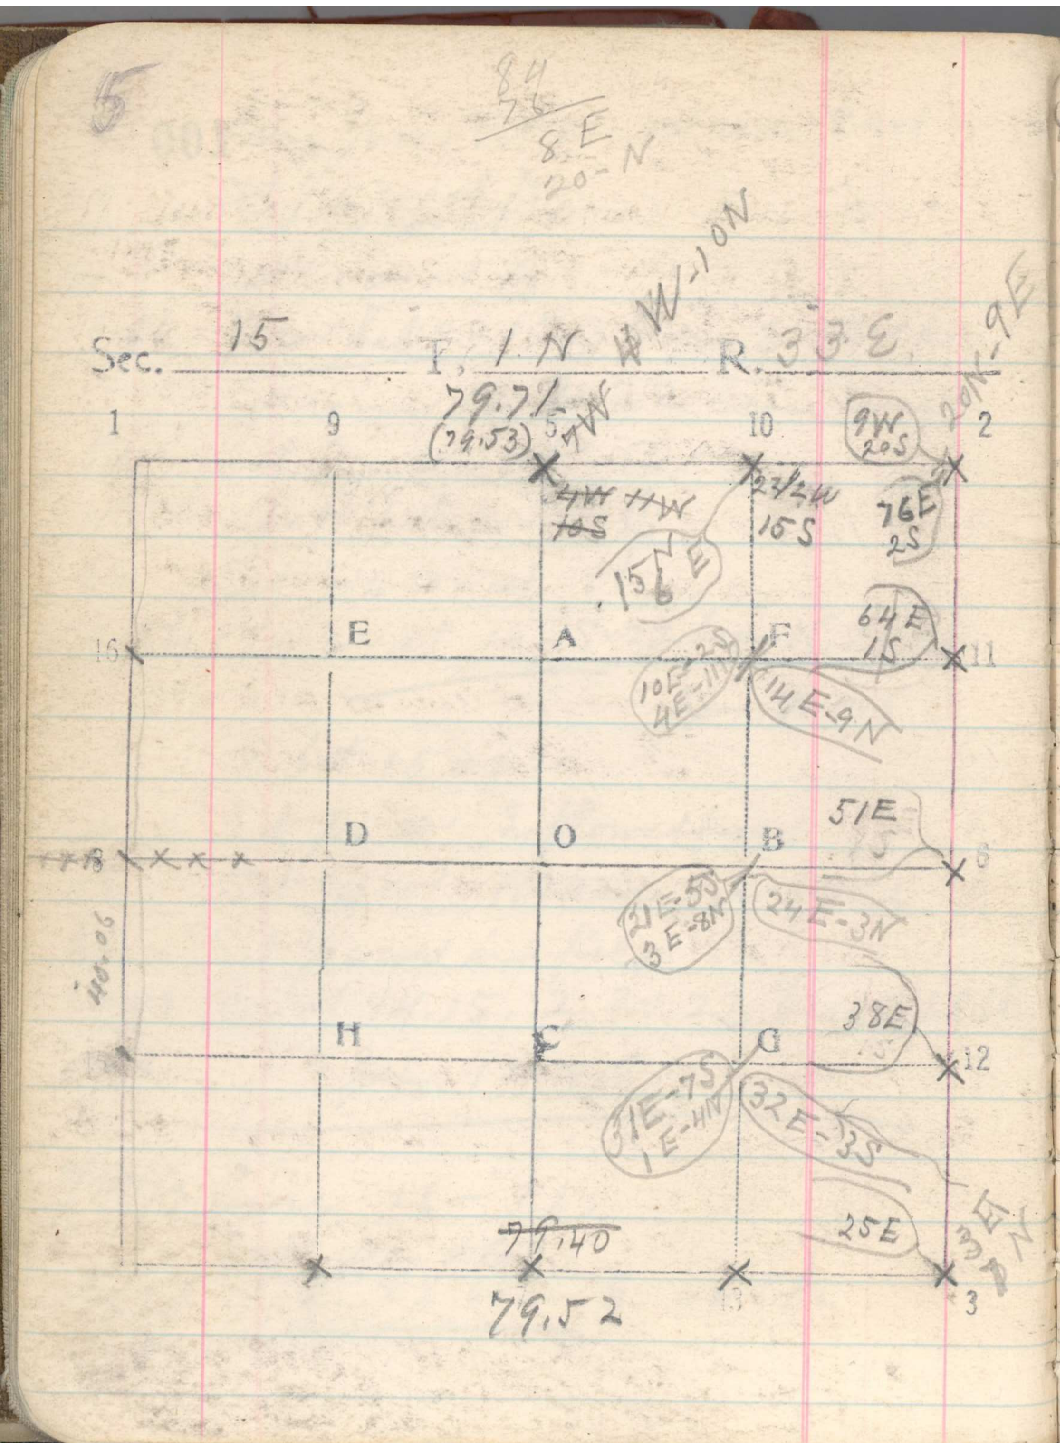

Dec. 7 From pt in center road, probable cor. of 15, 16, 21 & 22, run North

39.65 ~~39.94~~ In center road on line with fences to E & W. Thence continue north to

40.08 Intersect Cor of secs 9, 10, 15 & 16, a stone in center road, marked with 2 notches on E. & what appears to be 4 notches on S. set solid, with top on level with surface of ground, 2 lks. S. of fence to east 12-7-17

From temp cor of secs 14, 15, 22 & 23 run North bet secs. 14 & 15

20 Set 1/16 cor.

40 In grain field, No trace of 1/4 cor. Set 1/4 cor.

60 Set 1/16 cor.

80.00 No trace of cor of 10, 11, 14 & 15 Set stake

80.18 Wire fence, E & W, Fence cor, E. W. & N. bears East 84 lks.

continue North through grain field

100. Set stake. Fence cor, S & E. about 80 lks E of line

120 Set 1/4

140. Set 1/16

159.96 Point for cor of 2, 3, 10 & 11 as determined by measuring S 88° E 20 lks from Cottonwood 26 ins. Mkd bear East 82 lks.

No trace of other B.Ts.