7

61.10
.57
.53

81.06
.30
80.76

Sec. 28 T. 1 R. 33

81.04

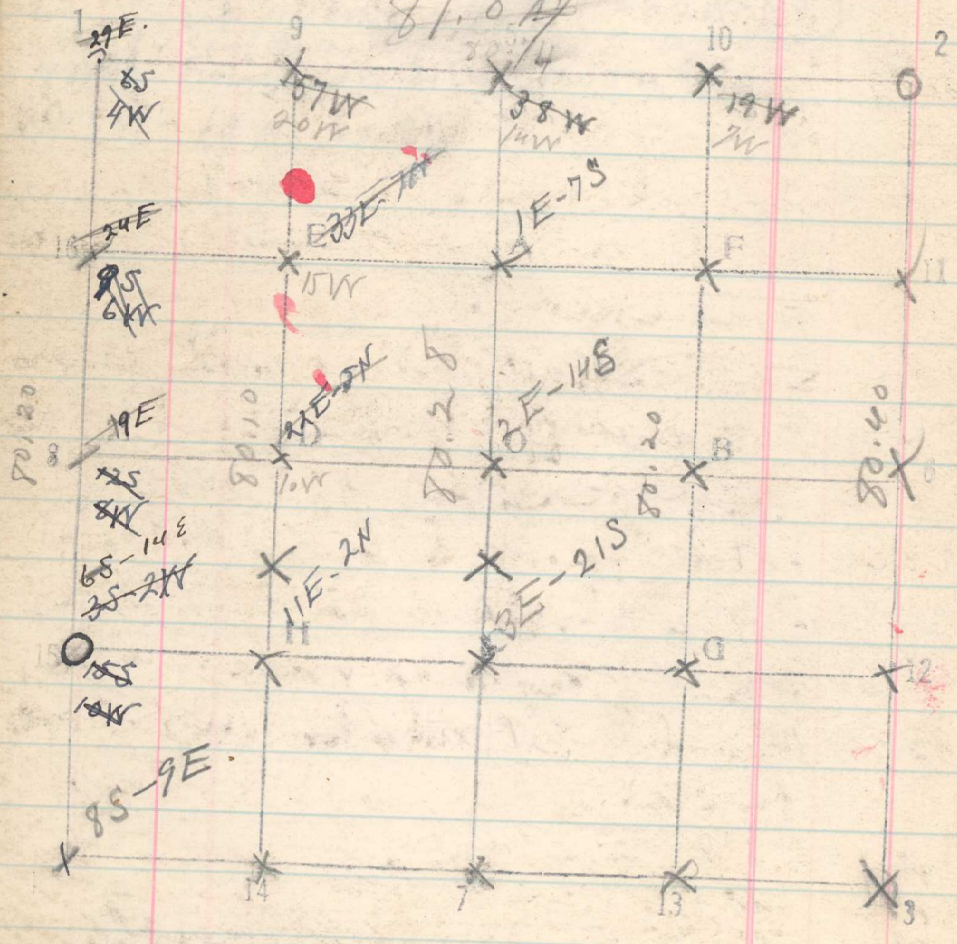

Dec 17 From cor of 21.22, 27 & 28 run West bet. 21 & 28

20 Set stake for 1/16

40 Set stake for 1/4 cor, No trace of 1/4 cor

40.52 Fence cor, N. E & W bears N. 42 lks.

61.10 Fence cor on line, E. W. & S.

80.68 Fence, N & S. on E. side of road.

81.04 Center road, N. & S. on line with fence to east and 8 lks. S. of center of road to W. which I accept as

81.04 (80.74) Intersect Point for cor of 20.21, 28 & 29 ~~as determined by running N. 60.18 chs from ⊗ by B.S. on cor of 32 & 33 on B.L.~~

Thence South

40.12 ~~Center of road~~ N & S on line with fences to E & W. Set stake ~~[illegible]~~ 26 lks. W of fence cor to E.

Thence S. on same line

20. Set stake

⊗ 20.06 What appears to be meant for a 1/16 cor, bears East 14 lks. Stones piled around in a circle.

40. No trace. Set stake for cor of 28.29, 32 & 33.

60 Set 1/16 cor.

80. Set 1/4 cor for 32 & 33.

100 Set 1/16 cor.

120.18 Cor of 32 & 33 bears West 12 lks.

Dec. 17