


2 T. 1 N R. 33 E

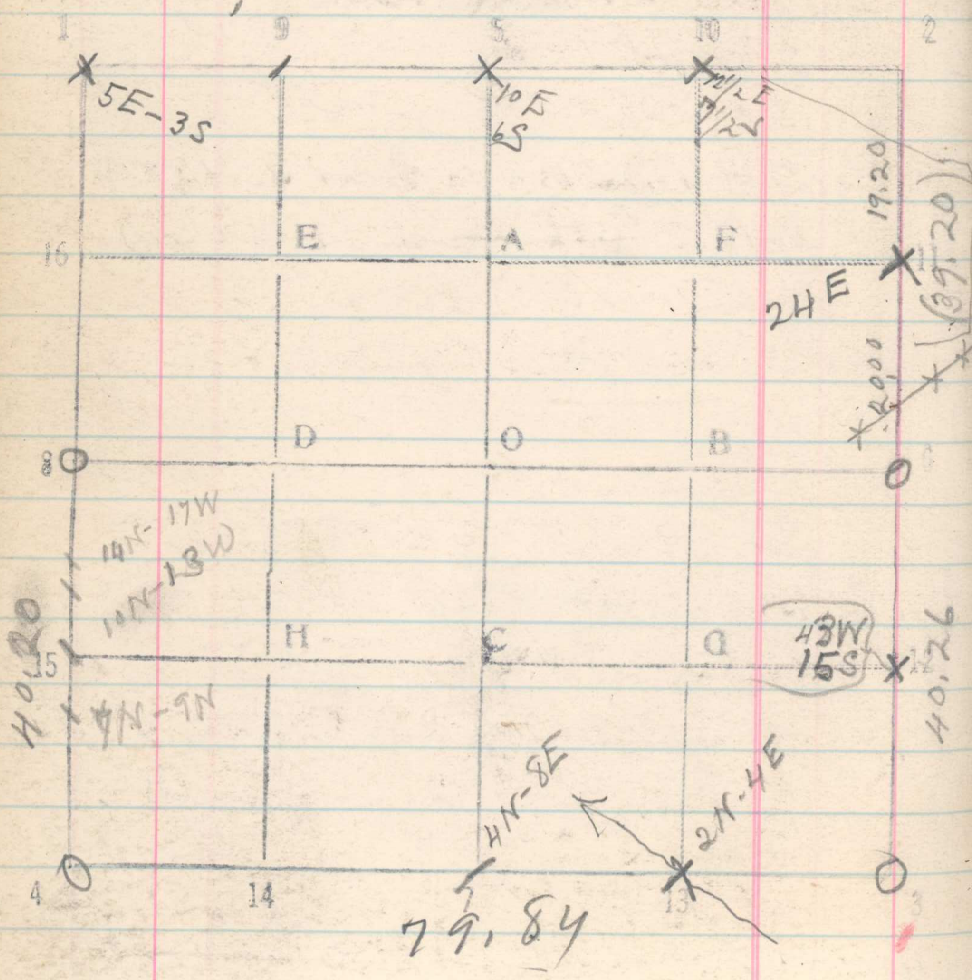

North bet secs 2 + 3

40.09 Intersect $\frac{1}{4}$ cor in road.
A big round fence post with
brace on N side east of cor. on E
side of road, $24\frac{1}{2}$ ft. E. of $\frac{1}{4}$ cor
thence North on same line.

39.00 Fence post on N side of road. ~~24.28~~
Notices of sec cor of 2. 3. 34 + 35
17 - 21 - 17 as established by me

38.64 ~~38.60~~ top sec. cor on Tp line ^{as established by me} bears W. $\frac{1}{2}$ ~~the~~ 16 cks.

From cor of 1. 2. 35 + 36 on N. bdy
run South

19.20 Set $\frac{1}{16}$ 24E

39.20 $\frac{1}{4}$ cor bears East 48 cks. A stone
firmly set with remains of pits N + S.
Thence South

19.98 A rock mtd $\frac{1}{16}$ bears W. 1 cks. (43W - 15S)

19.90 A rock mtd $\frac{1}{16}$ lying on bears W. 72 cks.

40.26 Cor of Sec 1. 2. 11 + 12 bears West 88 cks.
A alone in M.S.