


23

Sec. 3 T. 1 N R. 33 E.

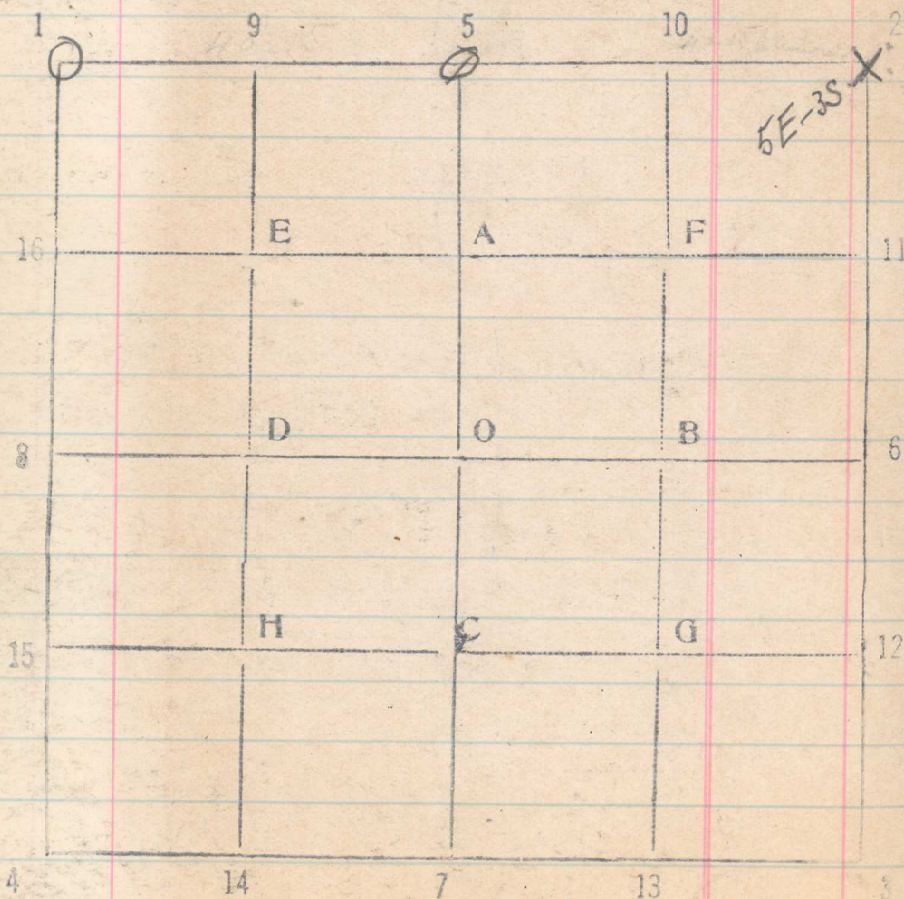

Sec. 4-1-33 119

From cor of 4.5.32 &amp; 33 run East in road

- 40.15  $\frac{1}{4}$  cor, a stone, not marked, on line,  
 80.30 Intersect point in center road where  
 Motanic says corner of 3.4.94 is  
 thence East on W bdy Sec-3  
 40.12 Intersect  $\frac{1}{4}$  cor, a stone unmarked,  
 firmly set, with small stone marked  
 $\frac{1}{4}$  alongside, on N side  
 Thence East on same line,  
 20.86 On line with fence to North,  
 20.16 A stone not marked, firmly set,  
 bears S, 6 lbs.  
 40. Notice. Set SS 15x6x5 for cor of 2.3.34 & 35  
 20 lbs. 20 ft 24 lbs. N of fence cor to SE.  
 40.21 temp stake at 39 chs. set from S. bears N. 36 lbs.  
 60.19 Center of road bet. two fence corners N &  
 S. bears S. 8 lbs.  
 80. No trace of  $\frac{1}{4}$  cor. Falls on <sup>S.</sup> bank of creek, West  
 80.07  $\frac{1}{2}$  Set SS 18x6x5 for  $\frac{1}{4}$  cor. M.S.  
 10001 <sup>head of</sup> water <sup>end of</sup> Set SS 12x8x4 for  $\frac{1}{4}$  cor M.S.  
 120.15 Cor of 1.2.35 & 36, bears S. 9 lbs. Stones  
 well marked in M.S.  
 Set it in ground & build M.S. W of cor