Dec 5
1917

From S & Tps 1 N Rs 3 & 4 E run West

4.13 Set S bdy Sec 36
20 Set 1/16 cor for Sec 36 (2E-45N)
24 Set 1/16 cor for Sec 1
40 Set 1/4 cor for Sec 36 Notice of old Std 1/4 cor. described as post + M.S.

44. Set CC secs 1 + 2
44.82 Temp. CC, set from S, bears N. 112 lks.
60. Set 1/16 cor for Sec 36
64 Set 1/16 cor for Sec 2
79.92 SC of secs 35 + 36, bears North 180 lks. This cor is a Basalt ~~stone~~ no marks discernable, in Md Stone. Set Basalt 12+12+4 + built M.S. 12-5-17 Rpts.
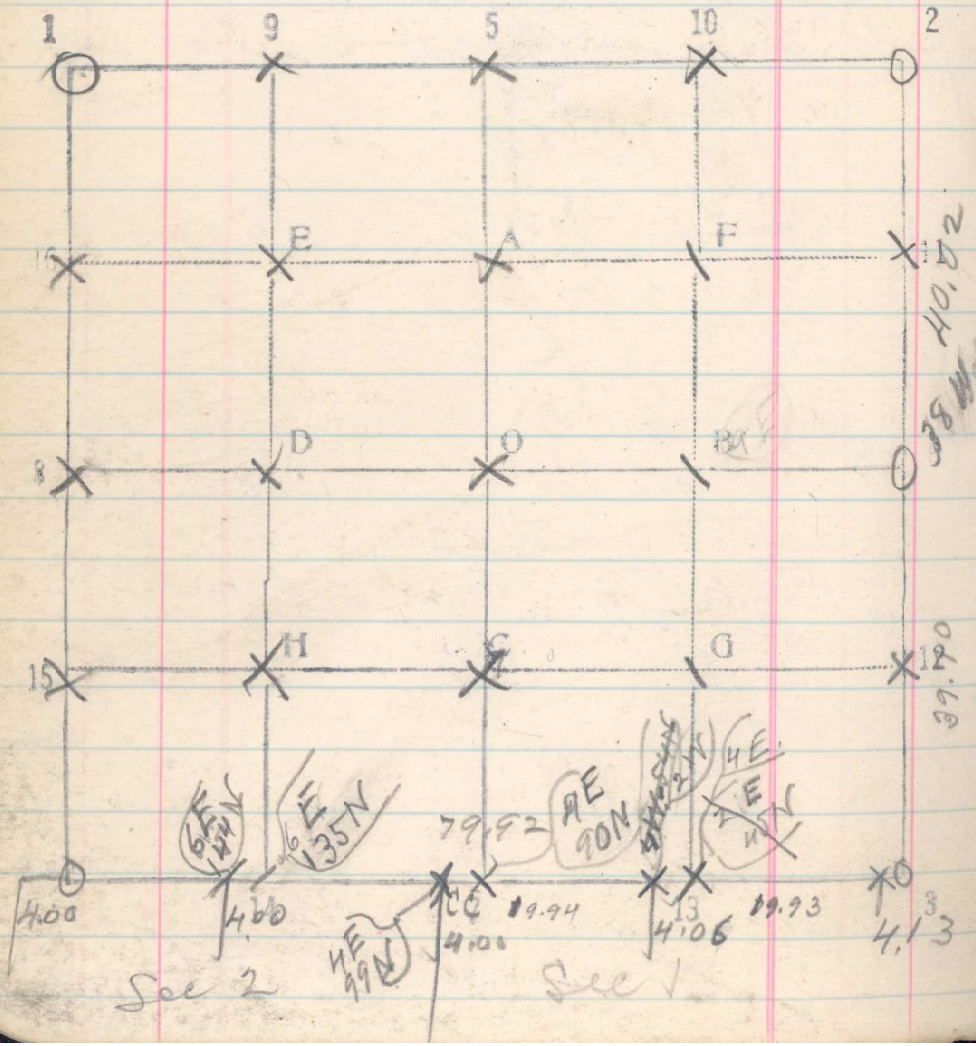
Dec 20 North on S bdy Sec 36
20. Set 1/16 Cor.
39.70 1/4 cor. a stone mkd 1/4 + iron post mkd 1/4 C 1 lk. S of stone witnessed by M.S. bears West 19 lks. Thence North on same line
20 Set 1/16 cor
40.02 Cor of Secs 25, 30, 31 & 36, bears East 39 lks. This is a stone with iron post 1 lk S. mkd 1/4 S