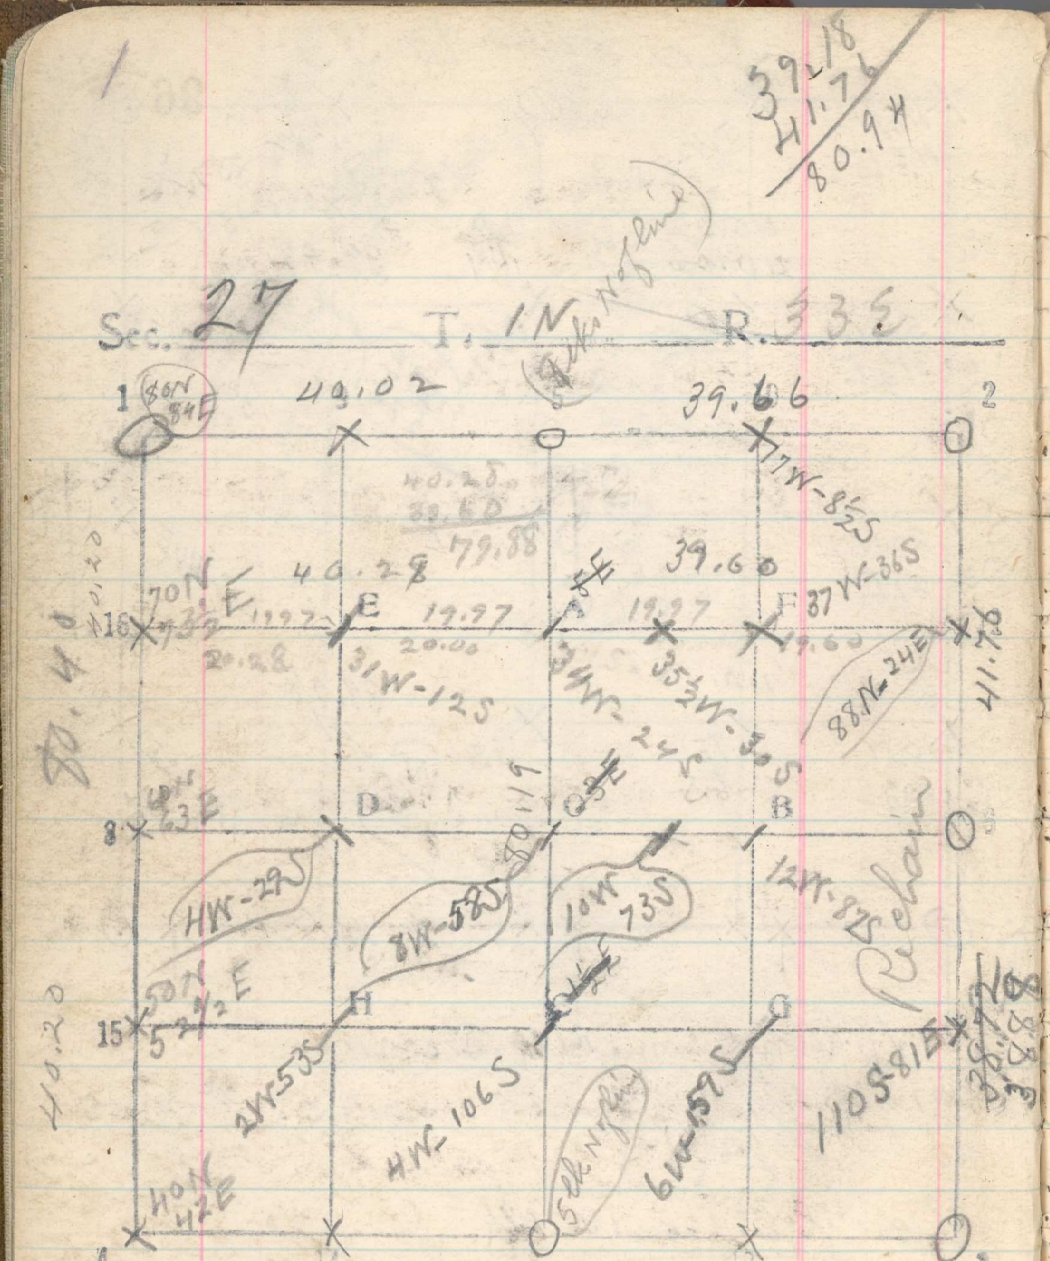

Dec. 8 From cor of secs 33 & 34 on Base line run North bet secs. 33 & 34

20. Set 1/16 cor

40. Notice. Set 1/4 cor

60. Set 3/16 cor

80. Notice. Set Stake for cor of 27, 28, 33 & 34 + raise M.S. on west
Continue north bet 27 & 28.

100.

120.

140.

160.80 Cor of 20, 21, 28 & 29 bears E, 84 lks.
12-8-17

80 North cor & bdy Sec. 27, from point 87 lks W of cor of 26, 27, 34 & 35 +46 lks N

20.46 Set 1/16 cor (110S-81E)

38.72 1/4 cor a stone plainly marked 1/4, with slight indications of pits, bears East 76 lks.

Thence North.

20.00 Set 1/16 cor (

41.76 Cor of 22, 23, 26 & 27 bears East 49 lks. a stone in M.S. 12-15-17