


Ser. H T. 1 R. 34

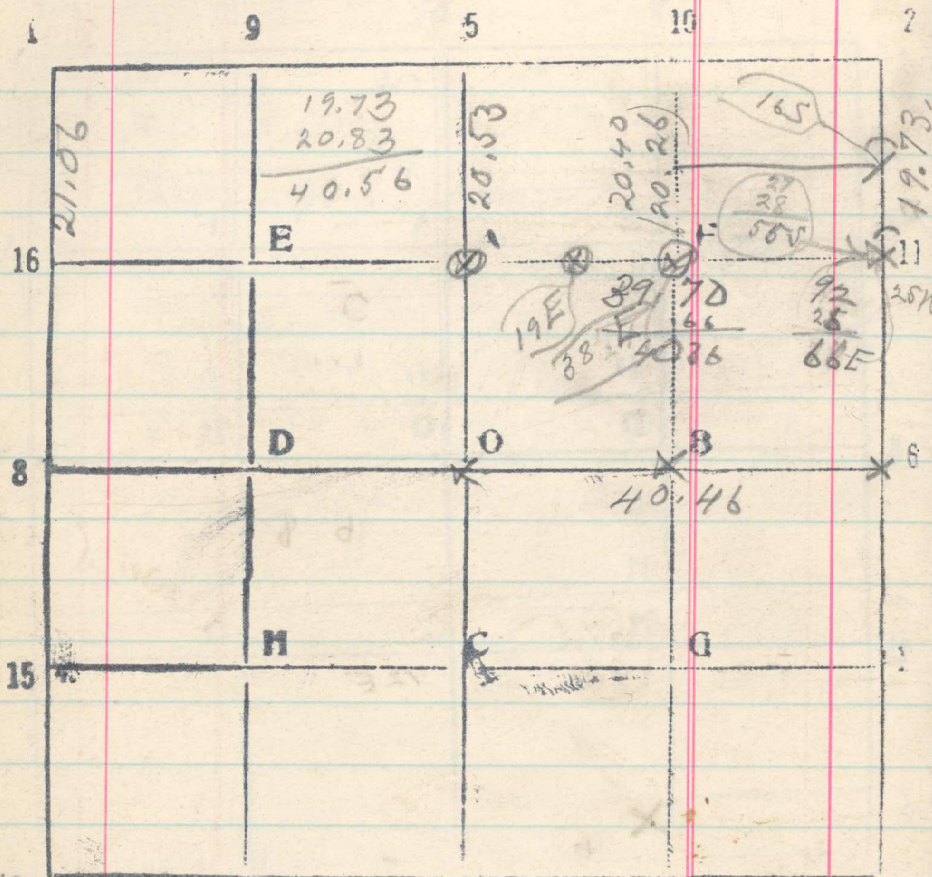

- 1979
 May 13 From ¹² A-run East
 10 Set 1/32 Co
 19.83 F-S. 4 bears N. 53 lks
 From O-run East
 10 Set 1/32
 20.23 O-S. 4 on fine lks (13) (5)
 40.46 Subunit pt for 24 Co. 13 lks. N E 14 lks

from old B.T.

224