39- 39-4. 3.2 12/3

1 & 2

Sec. ~~30~~ T. ~~1N~~ S R. 33E

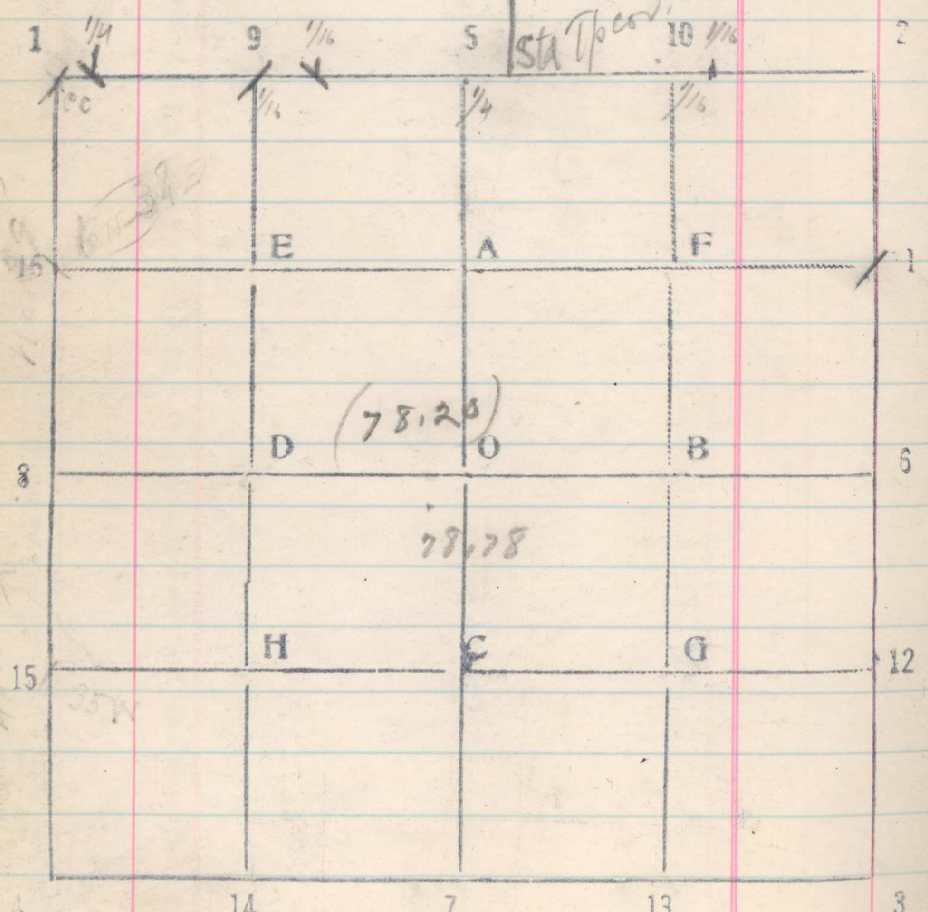

1917

46.42
1.12
45.30

45.30
90
46.20

74

Dec 5 From cor of 1.2.11 & 12, an iron post run north bet 1 & 2

20 Set 1/16 cor.

23. Road NW & SE

40 1/4 cor bears West 70 lks This is a stone in M.S. with large MS west of cor.

Then a North by BS on sec cor

20 Set 1/16 cor

45.30 Temp. CC set from E. bears East 82 lks.

(46.42) No trace of CC of secs 1 & 2 on Base Line

Set temp cor.

46.29 CC of Secs 1 & 2 bears E. 86 lks