Sec. 5 T. 2N R. 35E

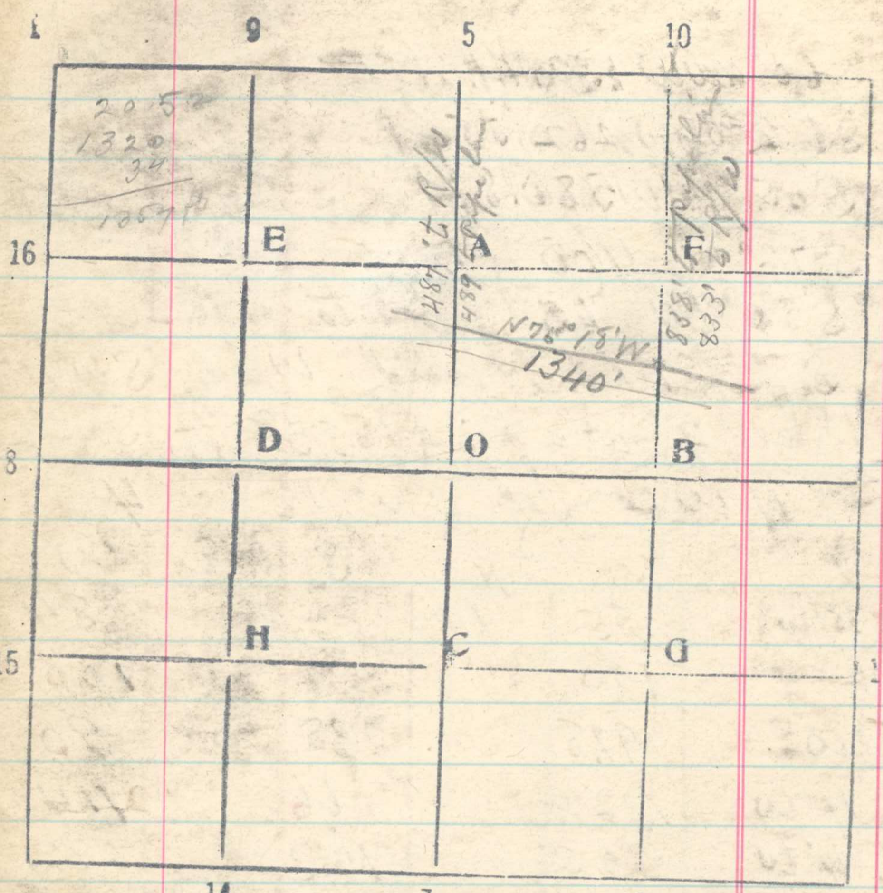

A strip of land 16½ ft wide lying on S. side and adjacent to the OWR&N R/W, and more particularly described as follows: Beginning at intersection of S. side of OWR&N R/W with east bdy SW¼NE¼ sec. 5-2-34 which is 833 ft. S. of NE cor. of said SW¼NE¼ sec. and running thence N 76° 18' W 1340 ft. along S. side of OWR&N R/W to intersection with W. bdy said SW¼NE¼ sec. 5, thence South 17 ft. Thence S 76° 18' E 1340 feet to E. bdy said SW¼NE¼ sec. 3. Thence north 17 feet to place of beginning; containing 5.5 of an acre, more or less.

June 1917

D. C. Burns Co.
208-210 Third St. Portland
Groceries to Hotels, restaurants & private families at Wholesale prices. Write for monthly price list

236

Ross Jones, Gibbon P.O.
Lives at Conway

	Inch	Posts required			
1S-33	153		1 ch	30°	13
1N-33	440		1 ch	25°	9
2-33	142		2.50	31°	36
1-34	208		.50	29°	7
2-34	517				65
3-34	65				
1-35	207				
2-35	640				
3-35	176				
2-36	90				
3-36	186				
	2824				