

30

(42E yellow W. of line)

From pt 10 lks E of W&E
 cor of sec 3, 4, 9 + 10 run South
 1/16 cor bears W. 4 lks.

15.02

Thence South on same line

20.45 RR. E on

20.08 Point for Wilkes' 44.00 bears
 E. 33 lks.

60.24 Cor of 9, 10, 15 + 16 bears E. 21 lks

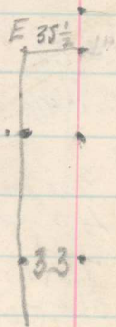
March 4

| | | |
|-----|-------|-------|
| 49 | 2.45 | |
| 33 | 12.25 | 22.45 |
| 282 | 23.45 | |
| 41 | 1.00 | - 20 |
| 4 | | |
| 45W | | |

From B-S. 9 run N

19.80 R.R. N85W. Old notes say 17.60 lks
 to R.R. N85W

19.82 Bradley's Corner


 $31.76^\circ = 3^\circ 11'$
 $174 \frac{2}{3} = 126$
 $\frac{172}{273}$
