34

Sec. 4. T. 2NR33 E

From 1/16 cor at C-S-4. a stone marked 1/16 on E face, at fence cor. N. S + E. run W

Set 1/16 cor. A. m. stone, probably old cor. 50 lks N and 47 lks W

40.26 ~~40.02~~ Temp 1/16 cor bears N. ~~166~~ 1.5 lks.

Thence South

~~17.00~~ 16.90 Bank of river Set stake

Stake bears E 19 lks.

point on N bank of river, north of 1/16 cor at 16-S.4.

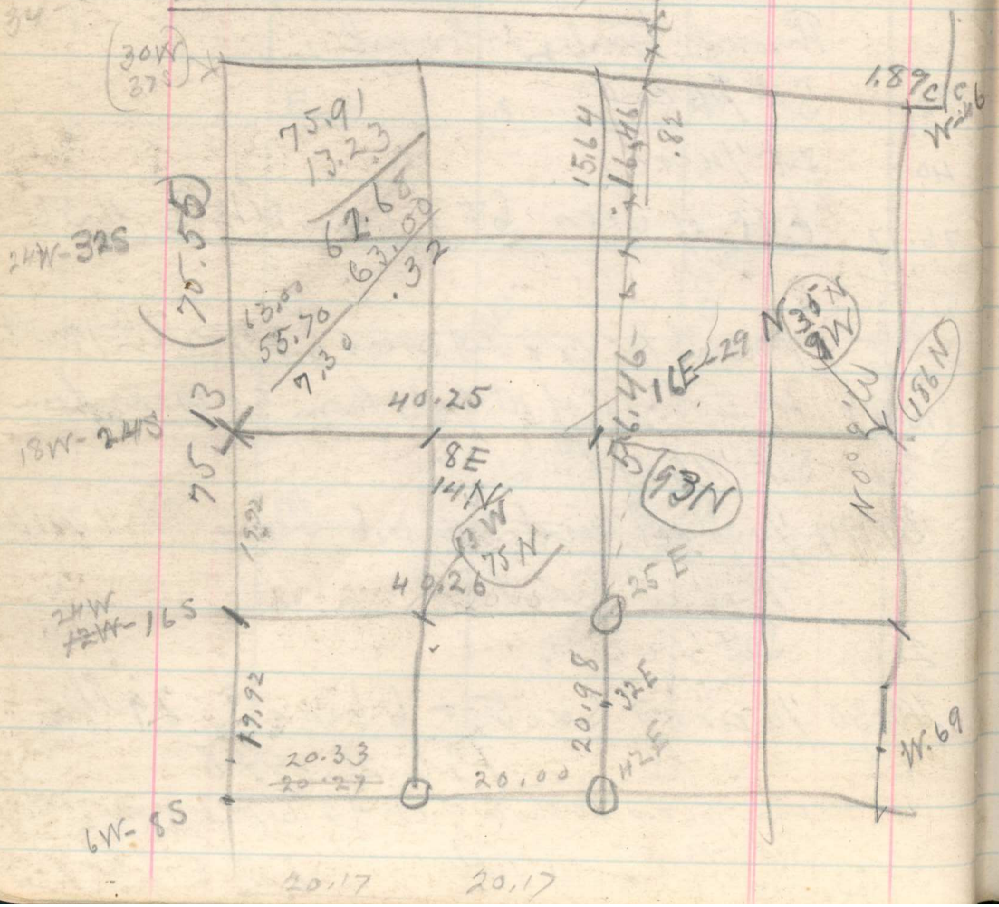

N. bet 4 + 5 from temp cor in r

1.44 N bank of river (Set stone 12 x 6 x 5 for W. C. 151½ lks N. of true cor pt marked 11111 on S 1112 on E 100 Ft on S

20. Set 1/16 cor (18W-24S)

40 Set 1/4 cor

75.13 (75.55) Cor of 4 + 5. 32 + 33. bears W. 30 lks.

From 1/4 cor bet 4 + 5 run East

20 Set 1/16 cor.

40.25 Intermit 1/4 cor at Center Sec 4 bears N. 29 lks

80.48 A rock marked 1/16 on W. face, firmly set. bears N. 186 lks.

(49 lks. W. of true pt. for cor. of 3.4.9 + 10)

From pt. 10 lks E of W. C to secs 3.4.9 + 10 which is S 5° 40' W 603 from true cor. pt. (S 6.00 + W 59)

run North

6.00 Point for cor of 3.4.9 + 10 falls in river Thence North

13.20 (12.20) Well bears W 20 lks

House on line

20.00 Set 1/16 cor. N W cor. of house is 180 lks. South and 2 lks. East

40.06 Astone marked 1/16 on W face, firmly set bears E. 25 lks (35N-9W)

75.91 (75.70) Cor of secs 3 + 4 bears East 3 lks.

CC of secs. 32 + 34, T 3NR33 E is 189 lks E of this cor.

March 2, 1918