Sec. 21 - 2 - 33

From cor of 15. 16. 21 & 22 run

20.37 Set 21 & 22, in road
Fence to E.

40 Set Stone for 1/4 cor in road (45-16 W

60.08 Fence to W. Set Stone for 1/16 cor in road

80.14 Point for cor of 21. 22. 27 & 28 in center of road. E & W & N & S bears W. 32 lks. Set stone

Thence West bet 21 & 28 in road

20.11 Set stone for 1/16 cor

40.22 Set stone for 1/4 cor.

60.31 Fence to S.
~~Fence to North~~

60.33 Set stone for 1/4 cor

80.45 Point for cor of 20. 21. 28 & 29 bears N. 16 1/2 lks. in center of road. E & W & N & ~~S~~ on line with fence to S. Set stone 48 lks. N of fence corner

North bet 20 & 21

20 Set for 1/16 cor -30 N - 20.45 on line with fence 1/2 mile East

40 Set stone for 1/4 cor - 8 W - 79 N

60.93 Set stone for 1/16 cor 12 W - 93 N

~~81.20~~ center of road to W.

81.20 Point for cor of 16. 17. 20 & 21 in center road to E, 37 lks. W of fence to S & 22 lks. E of fence to N

Thence N bet 16 & 17

40.18 Set stone for cor. 40 lks. W. of fence post E. N & W.

80.33 Cor of 8. 9. 16 & 17 bears West 42 lks.
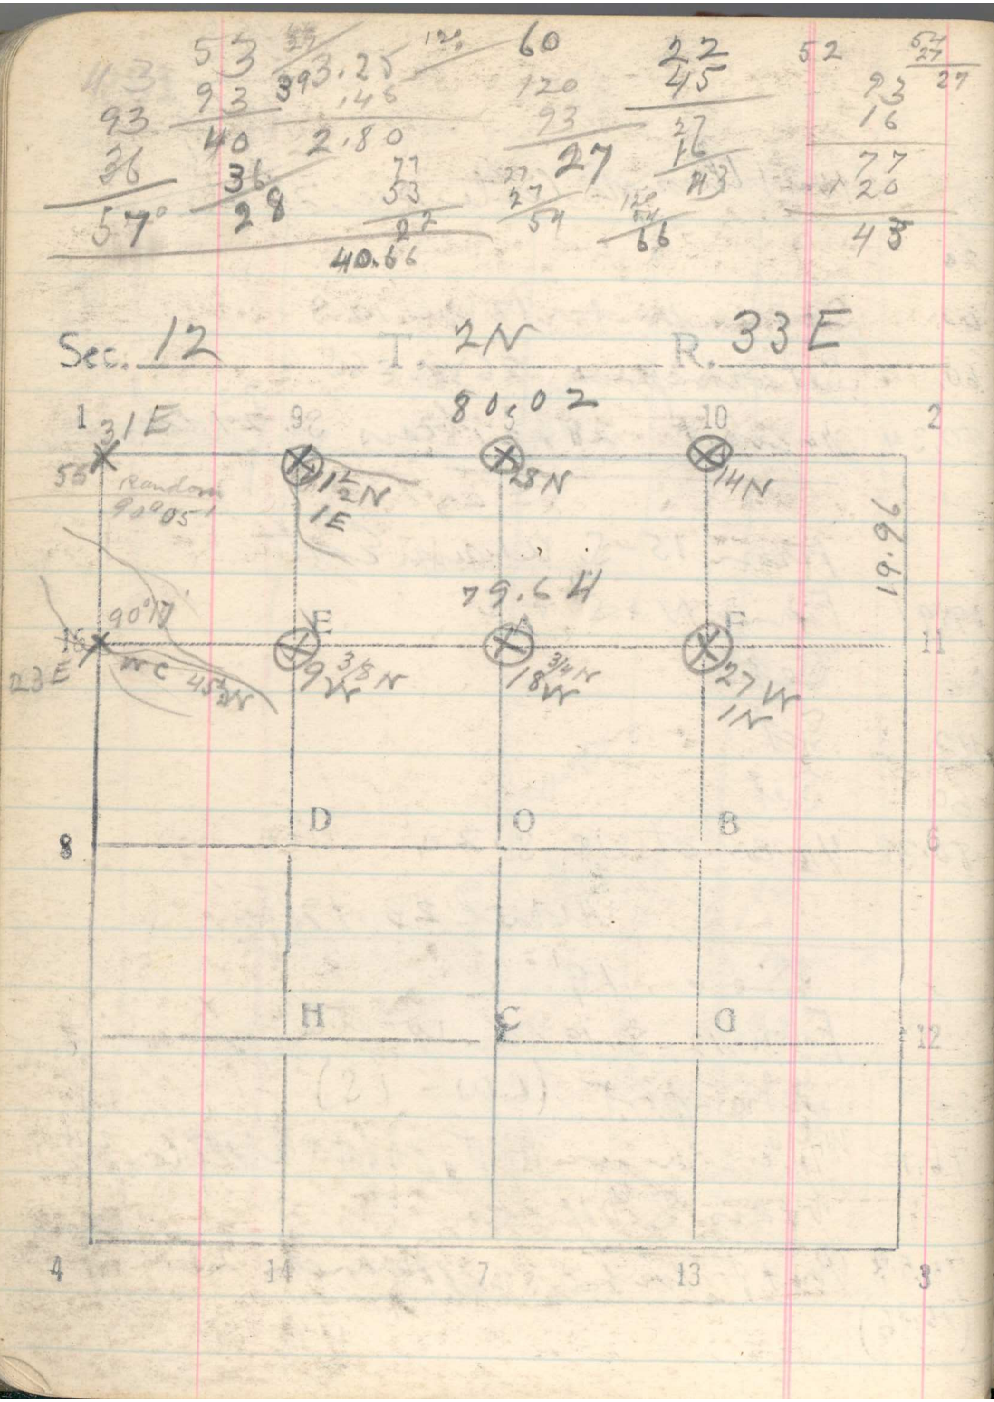
March 27, 19