46

Sec 30 - 2 - 33

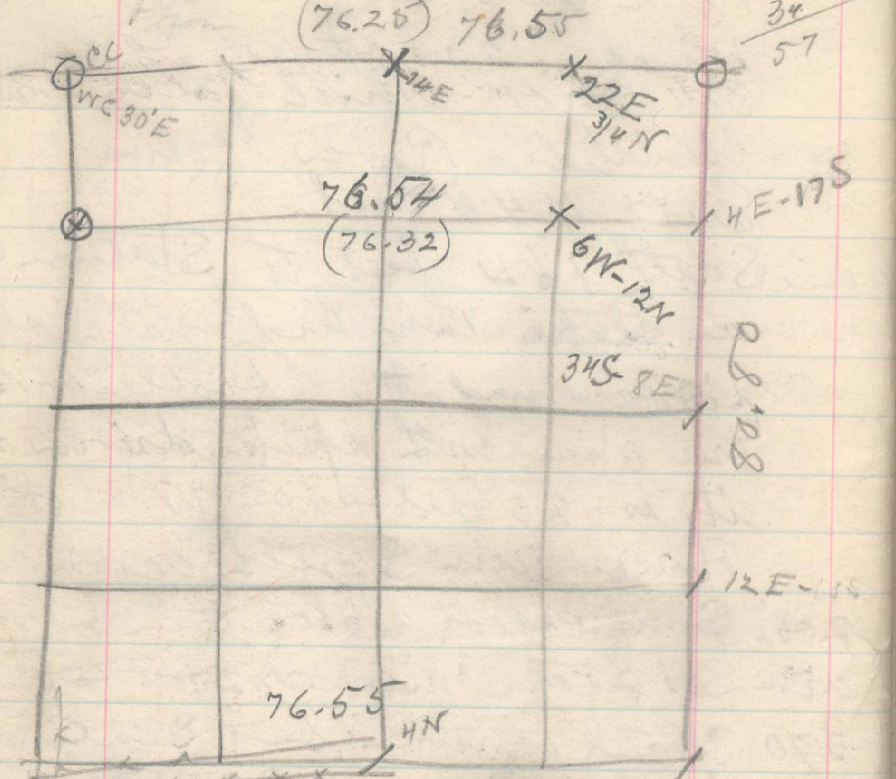

46
23
34
57

From CC of sec. 19+30 mm S89°45'E

36.25 Set stone for 1/4 cor in road

~~56.25 Set~~

76.55 (76.25) Intersect Cor of 19, 20, 29+30, a stone in road, marks nearly obliterated. I mark it (X) on top 2 notches S+E. Set stone for WC 123 ft. N and Iron post for WC 30 ft W + 30 ft S

Fence 2 S
Fence 30 N

Thence South bet 29+30 in road

20 Set

40 Set

40.34 Fence, E.

60 Set

60.89 Fence, E+W

80.80 Center of road, E+W+N+S, bears E, 16 lks, Set stone for cor of sec. 29, 30, 31+32 in center of road, Mar 20, 1918

West bet 29+30

38.05 Fence to N, 195 lks E of line,

40.06 Set stone for 1/4 cor in road

76.55 CC of secs 31+32 bears N 7 lks,

~~76.53~~ Center of lane to East is about 60 lks

(76.55) S. of line, and on line with cor of secs 25+36

From 11 - S. 30 mm West

20.06 Set Iron post

76.54 (76.32) Point for 1/16 cor, in road bears N. 116 lks Iron post for WC, 30 ft. East

March 22, 1918