Sec. 21 T. 2N R. 34 E

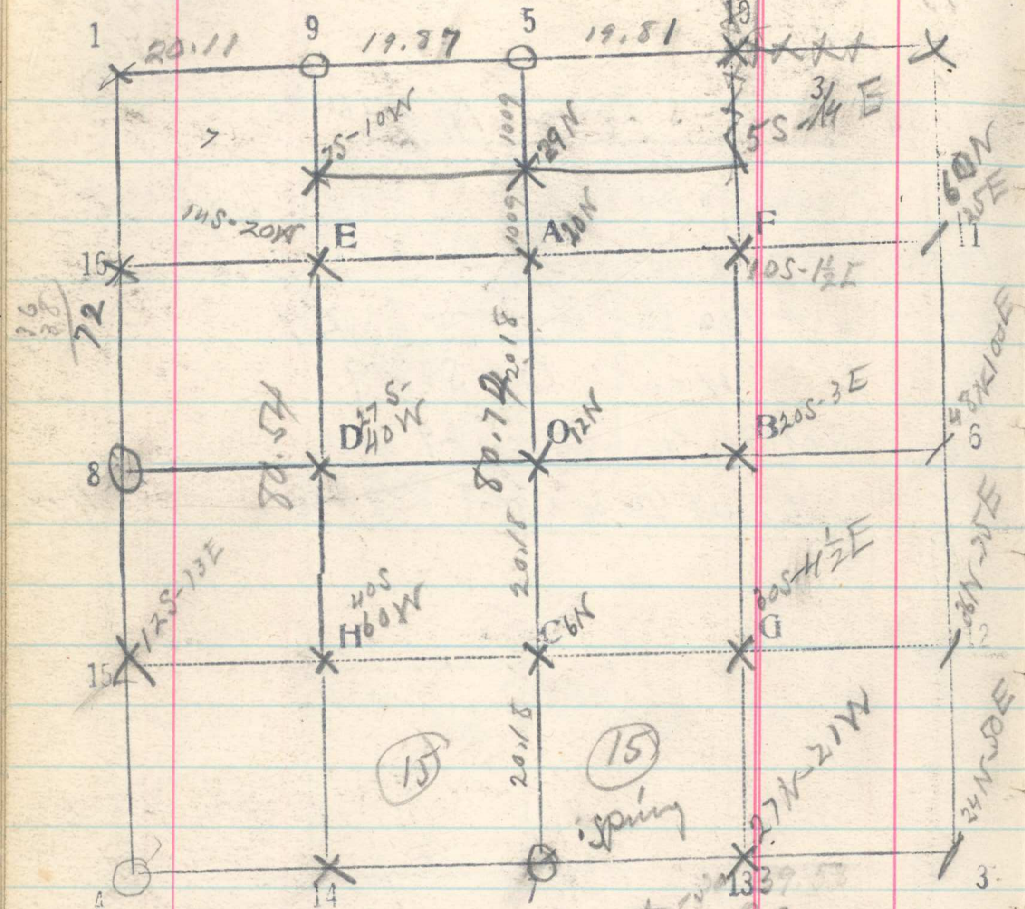

Dec. 2 From 10-S.21 run west by BS on cor 2

19.81 Remains of ¼ cor bears N 19 lks.

39.68 1/16 cor 9-S-2 bears N. 23 lks.

59.79 Cor of 16.17.20 & 21 bears N. 38 lks.

South from Cor 9

10. Set 1/32

20 Set 1/16 E-S.21

40 Set 1/16 D-S.21 + 60 Set 1/16 · 80.54 Cor 14 bears west 80 lks

From ¼ cor bet 21 & 28 run North

20 Set 1/16

40 Set ¼ cor O-S.21

60 Set 1/16

70 Set 1/32

80.72 ¼ cor bet 16 & 21. Dec. 2, 1918

208

50
21
.71
.91

39.65
.4
39.79

39.65
80.50
120.15

80.58
40.00
120.58
15
.42
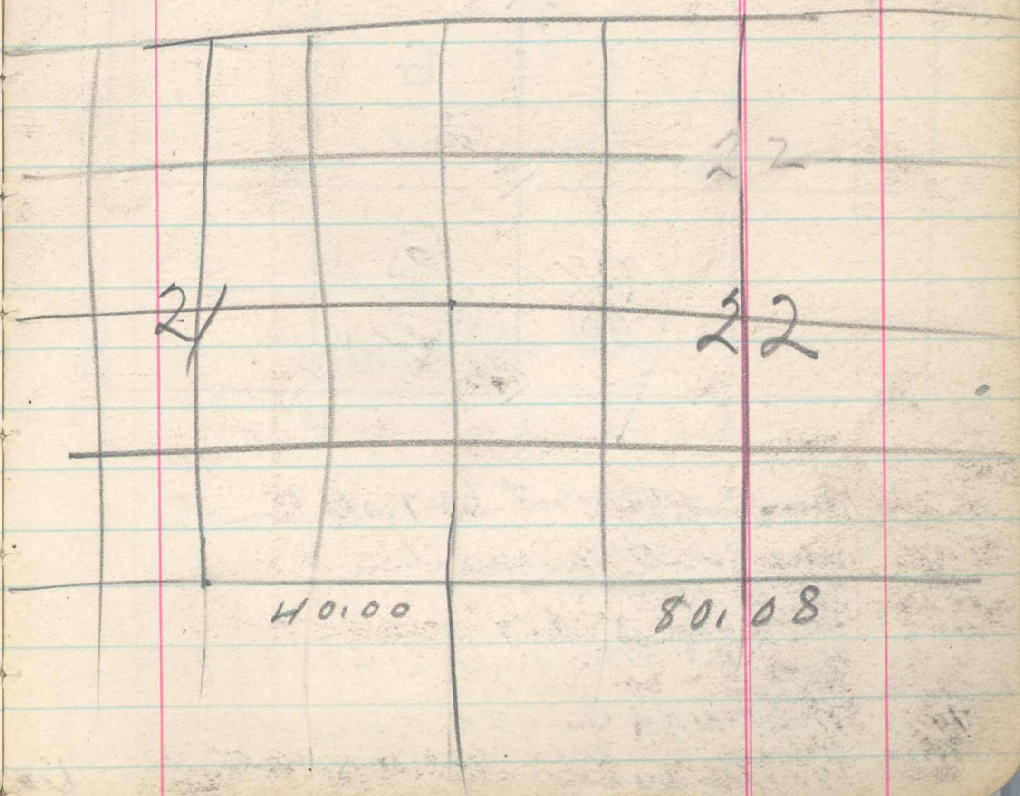
6 | 42
7