


Sec. 11 T. 2N R. 3E

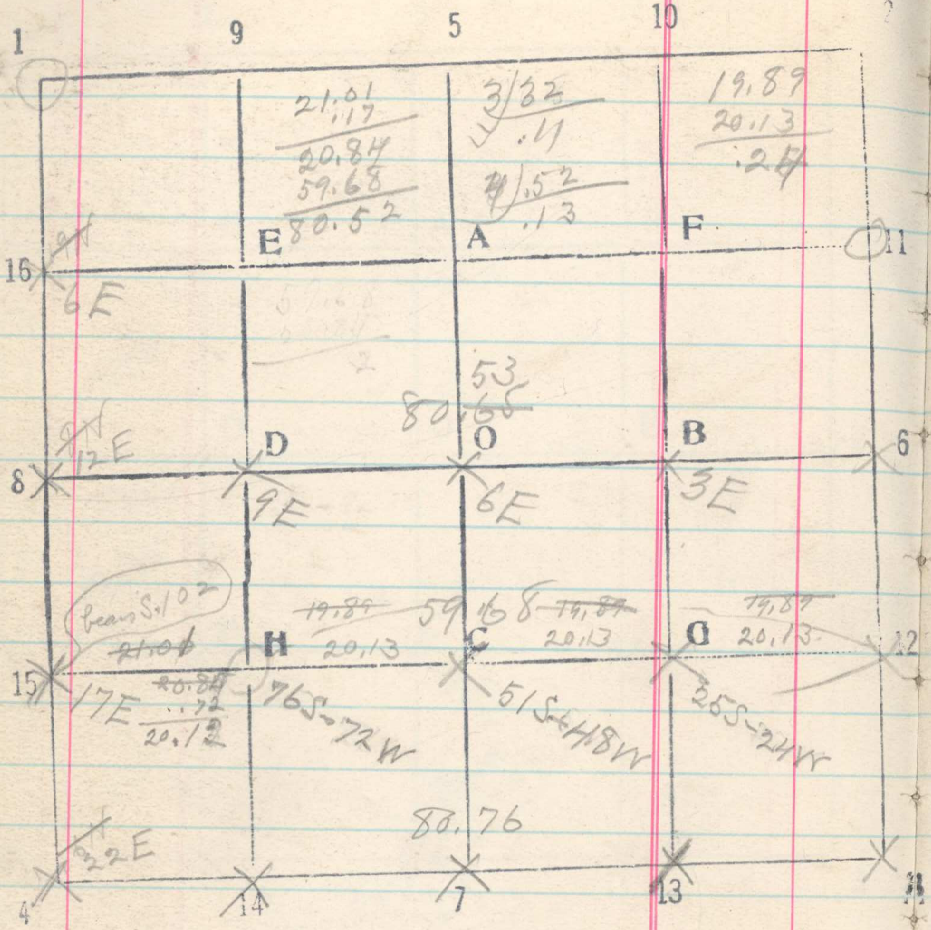

From H - S. 11 run west by P. Son 12

20. 21.00 Set temp 1/16 cov. 15 - S. 11 bears S. 102 lks.

From temp cor of 10, 11, 14 & 15 set from

20.00 S. run north bet 10 & 11 Set 1/16 cov

20 5.7 Temp 1/16 cov set from West bears E. 17 lks
 21.02 Temp 1/16 cov set from E. bears E. 21 lks
 21.09
 40.00 Set 1/4 cov
 60.00 Set 1/16 cov ft E. of fence on W. side
 80.12 Intersect cor of 2, 3, 10 & 11 March 5, 1919

From cor of 11, 12, 13 & 14 run west

20 Set 1/16 cov. Notice of old cov
 20.91 Fence N & S.
 40.1 Notice of 1/4 cov. Set stake 15 lks E.
 40.10 Curb. N.
 60. Set 1/16 cov. Notice of old cov
 80.98 Cor of 10, 11, 14 & 15 bears S. 38 lks.
 - .72
 80.76