Sec. 14 T. 2N R. 3 E

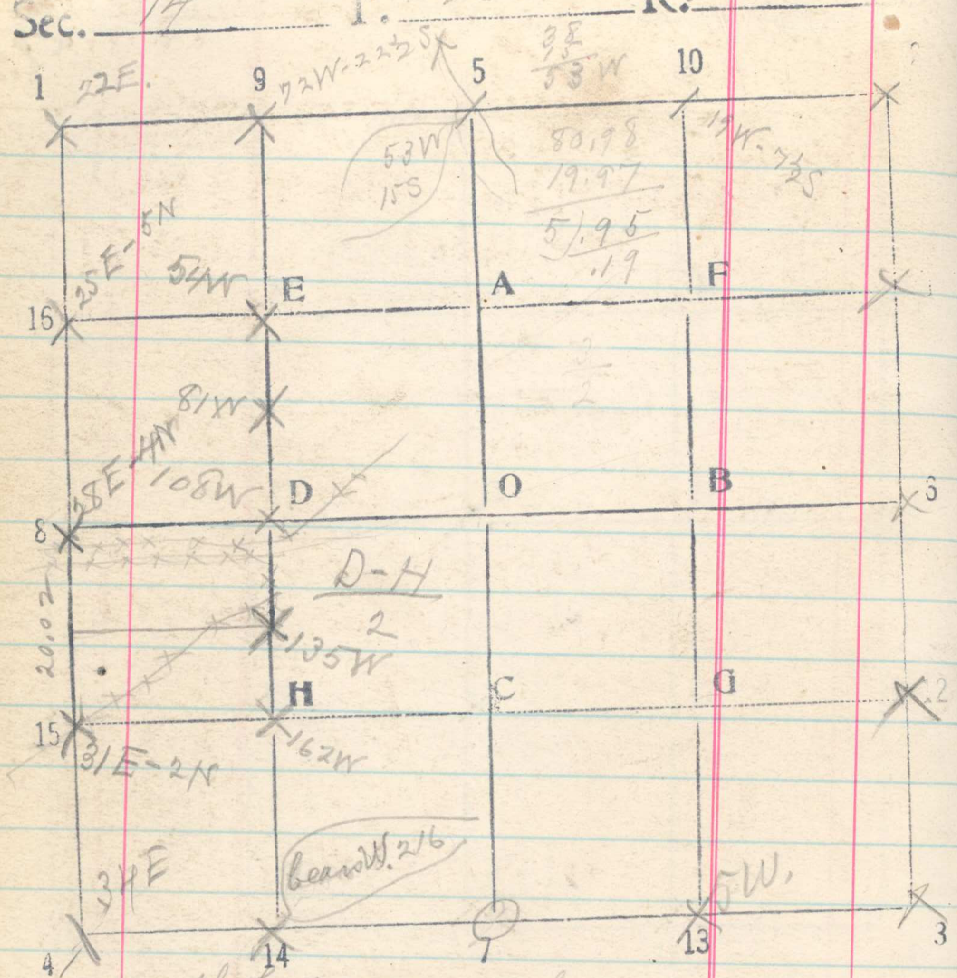

North bet 1/4 & 15 from temp sec cor.

.97 Temp cor set from W. bears E. 3/4 lks

20.00 Fence, N 90° E. Set 1/16 cor. Notice

38.35 Fence, E & W

38.81 Fence E & W

Set 1/4 cor. Notice

59.80 Trace of old fence line, E & W

60 Set 1/16.

80 Set cor of 13-11-14 & 15

From 9 - S. 14 run South

20 Set ~~S. 14~~

30 Set $\frac{E-D}{2}$ S. 14

40 Set D - S. 14

50 Set $\frac{D-H}{2}$ S. 14

60 Set H - S. 14.

80. Temp 1/16 ~~S.~~ H - S. 14 set from 20.

bears W. ~~2 1/4~~ $\frac{2\,16}{}$ lks.

From pt. 97 lks. S. of temp cor of 14. 15. 22 & 23, set from W. bears East

20 Set 1/16 cor.

39.94 Intersect old 1/4 cor, a stone mkd 1/4 on N. face,

Contine East on same line.

20 Set 1/16 cor.

40. Intersect Cor of 13. 11. 23 & 24 March 7, 1899