Appointments in Sec. 13- Jos Pond, Allen Patawa

Sec. 29 T. 2 N R. 3 E.

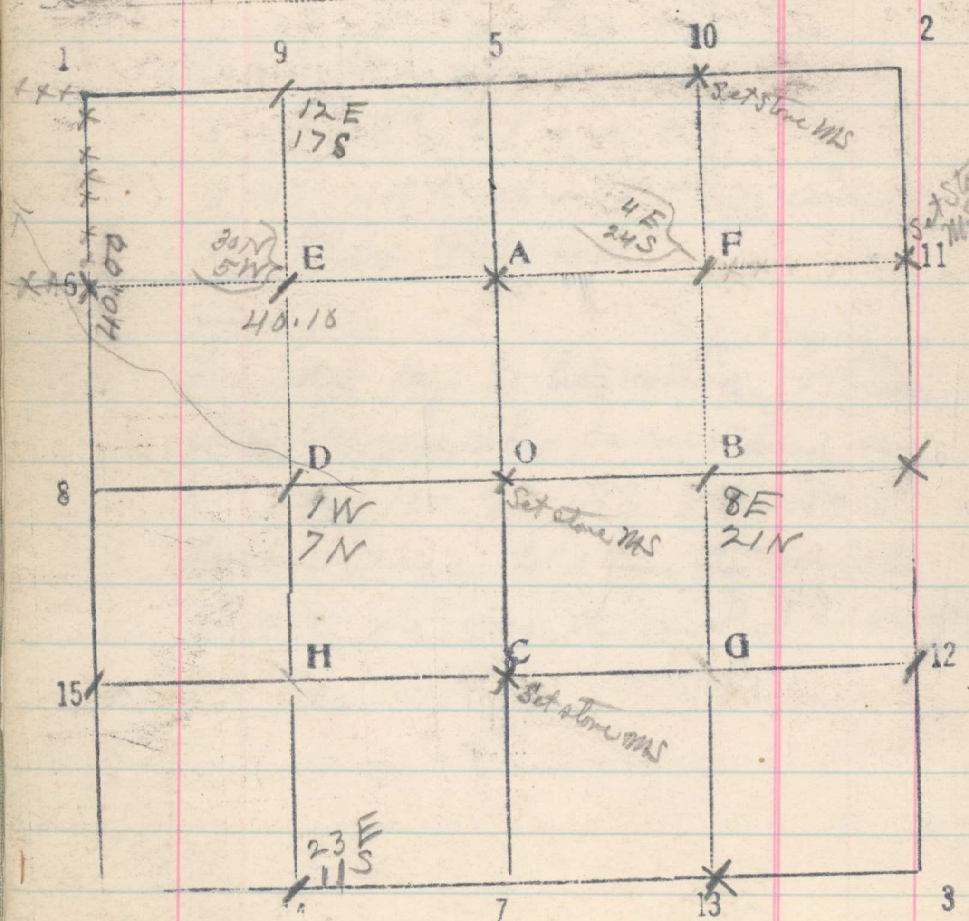

Nov. 6 From Cor of Secs. 19. 20. 29 & 30 run South bet 29 & 30, Set 1/16 cor. 57

Intersect Ye on bet secs. 20 & 29,

From 1/16 cor at A - S - 29 run W.

20 Set 1/16 cor.

40.10 1/16 cor at 16 - S - 29 bears N. 60 lks. This is a stone marked (A) on top & 1/16 on N face, with M.S.

Nov. 6. 1917

2