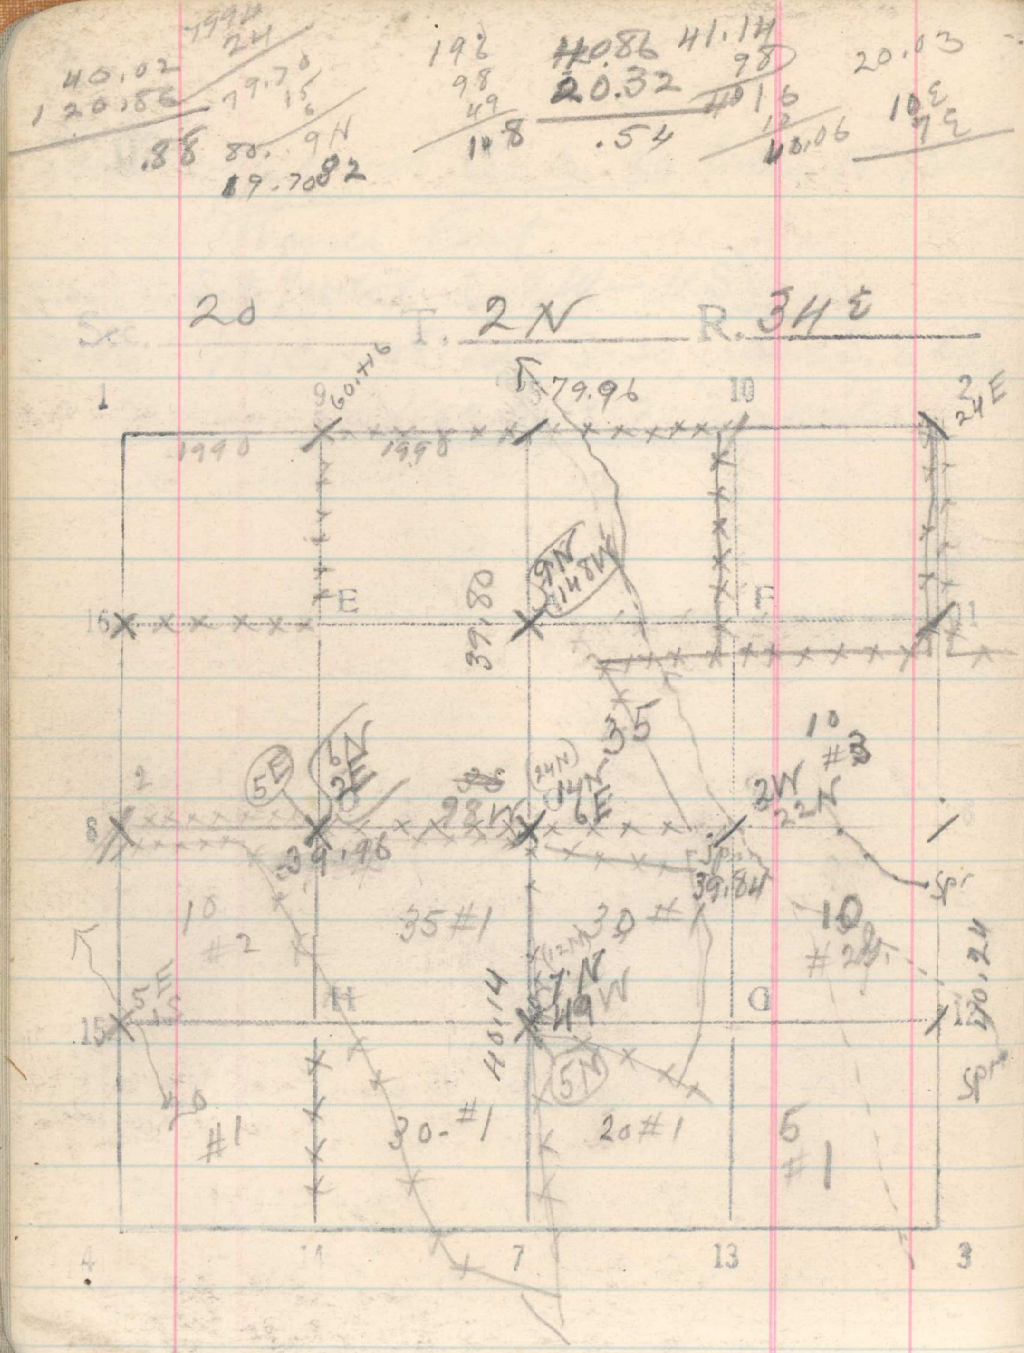

From 1/4 cor bet secs 20 + 29 run North.

20 Set 1/16 cor

40 Set 1/4 cor at O - S. 20. Enter wheat stubble

60. Set 1/16 cor.

79.94 Fence E + W A fence post bears W 1 97 lks braced E. W + S as for a cor. post.

From this fence post run West.

fence on line.

19.90 Fence cor on line, N. S + E. No trace of 1/16 cor described as Chand stake. P + M.

20 Set stake

40. No trace of cor of secs. 17. 18. 19 + 20.

Thence South toward Cor of 19. 20. 29 + 30

20 Fence E + W No trace of 1/16 cor dis. as 12 x 12 x 12 P + M.

39.70 Fence. E + W

40 No trace of 1/4 cor

40.02 Set basalt 15 x 10 x 7 Mid stone

40.70 Fence, E + W.

59.46 Fence cor. bears E. 18 lks. S + W.

60. No trace of 1/16 cor. Set stake for 1/16 cor over