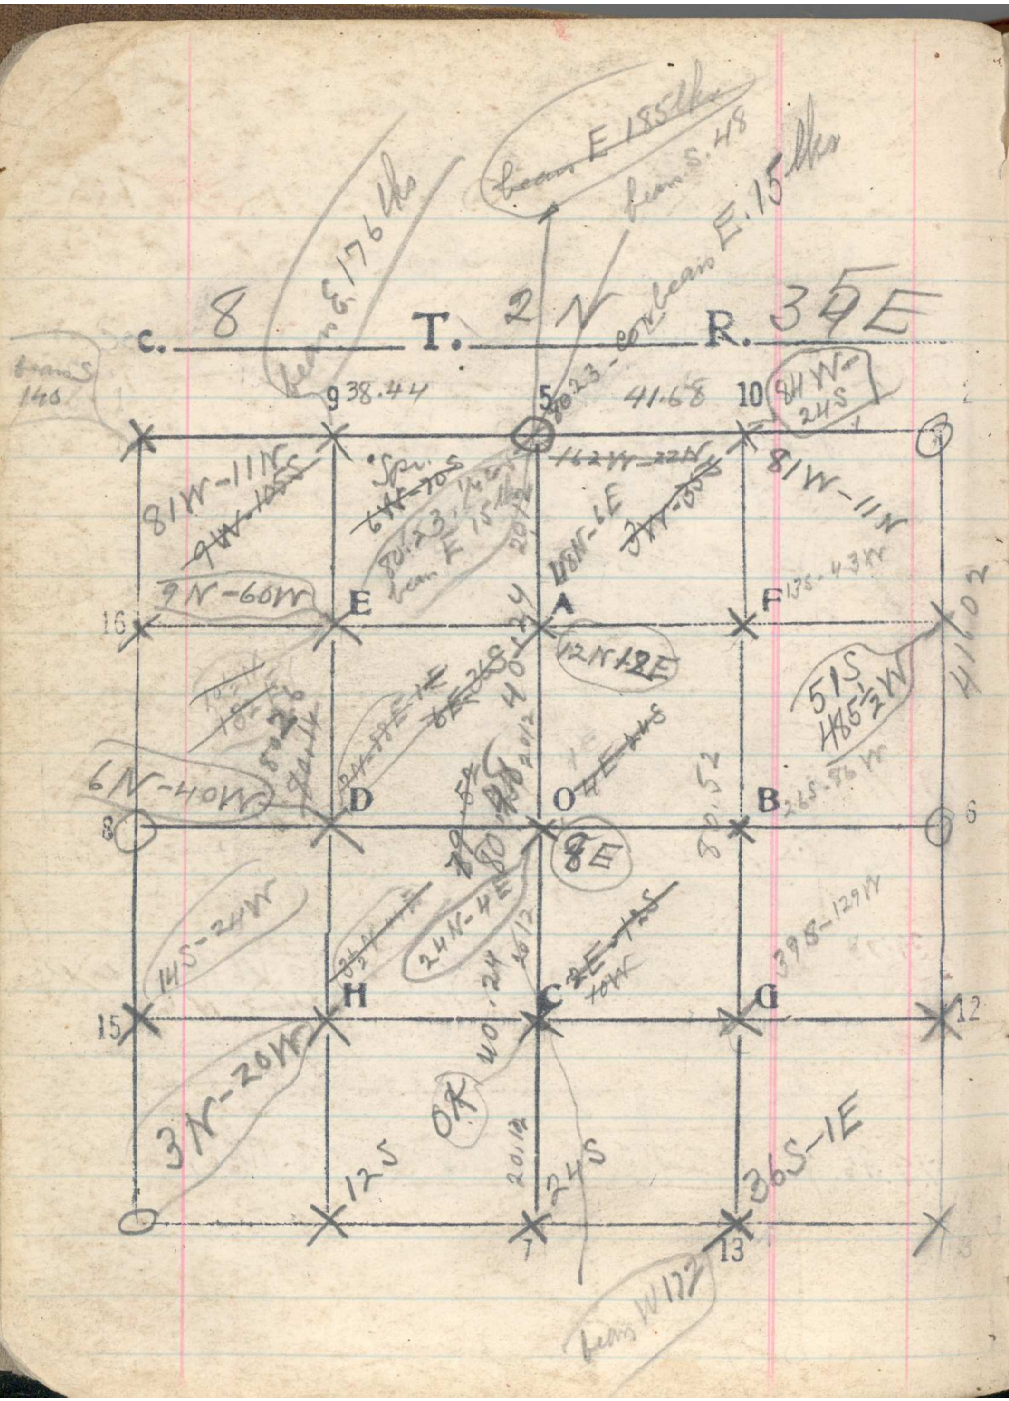

162 W-22 N 70 S
48 N
22 N