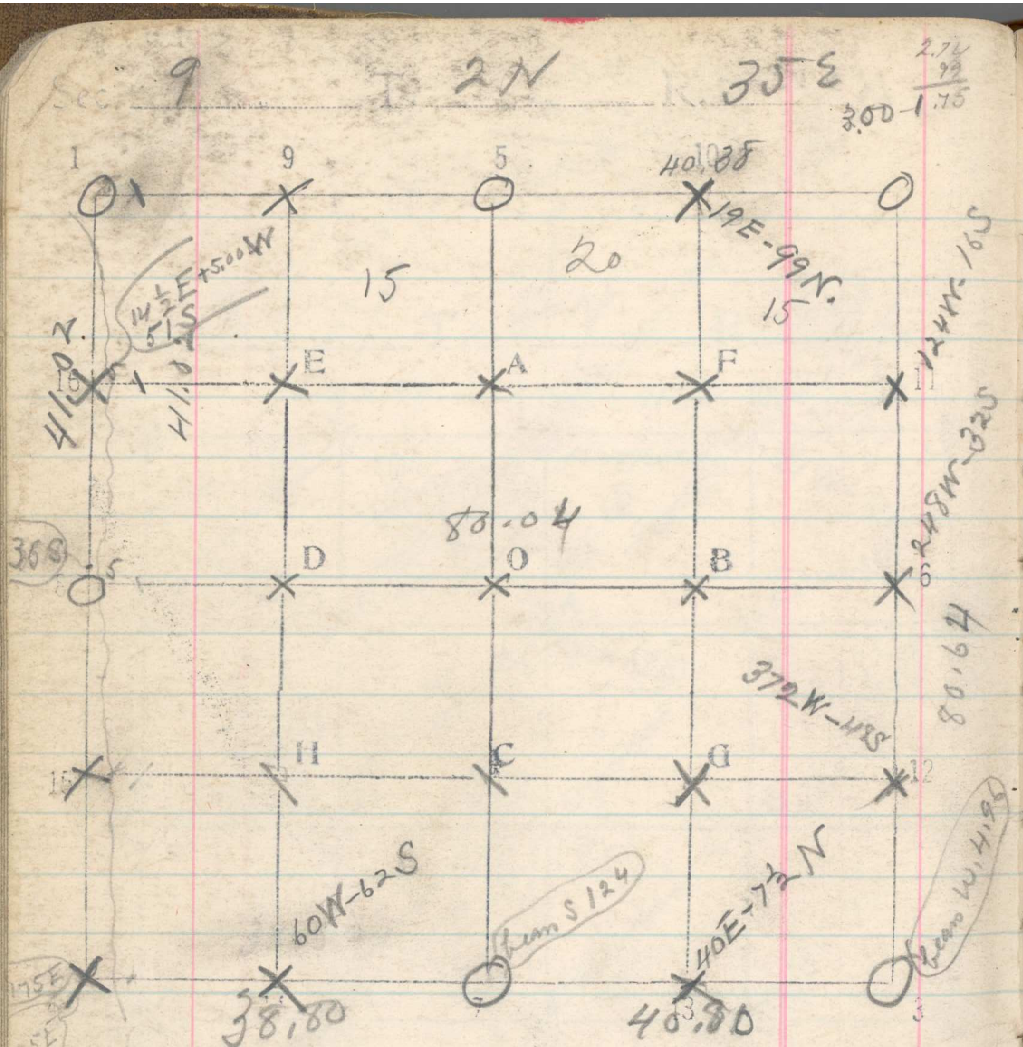

East 3.00
S 1½ E

East	2m
S 1½ E	20.50
S 45° E	36.00

N – S	E – W
20.	
25	25
45.	32.00

155