Sec. 1 T. 2 R. 35

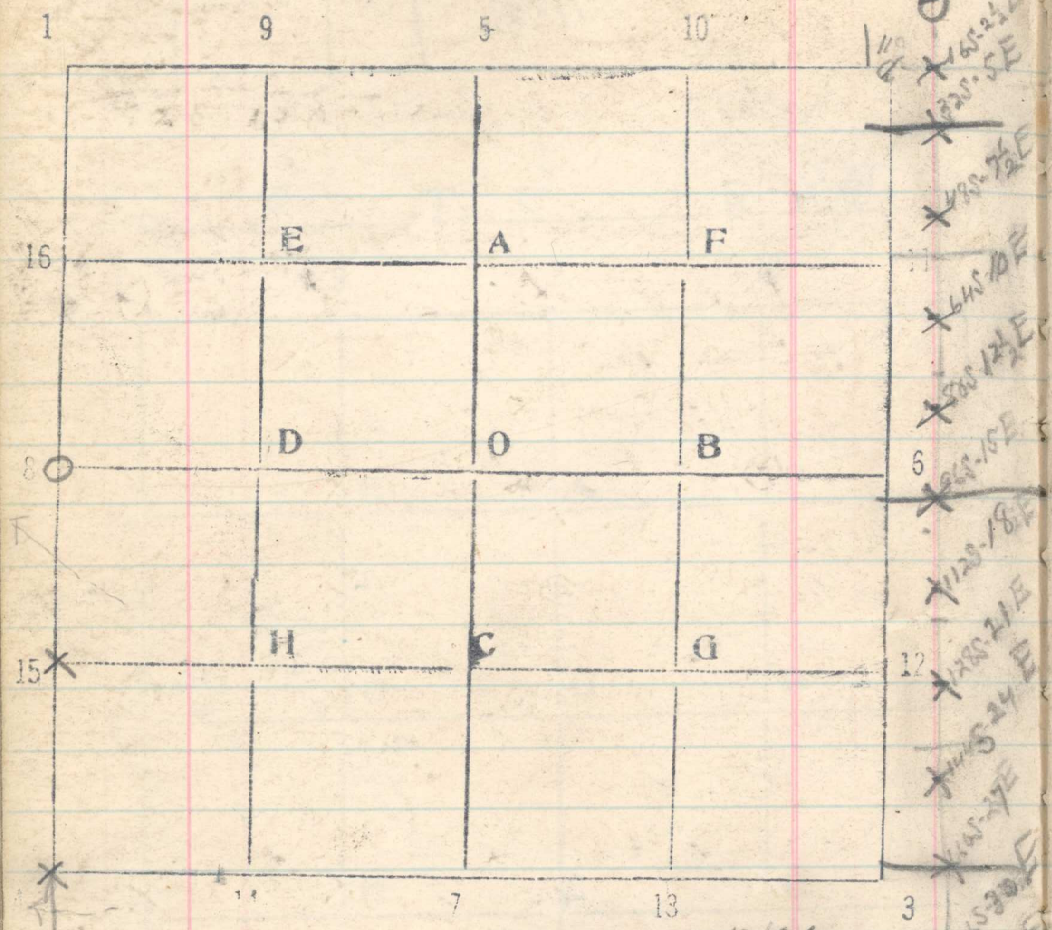

3/192
4/64
16

12/36
3

June 11. Commence at ¼ cor bet 1 & 2 located by mass.
S 45° W. 23 lks. from Pine 15. mkd ¼ 15 BT
Pine 24 N 89° W. 26 lks (106) (106 lks) mkd

20 Set 1/16 cor

40. No trace Set Cor of 1.2 & 11 & 12

Thence South on same line bet 11 & 12
20 Set. stake for 1/16 cor. Rang East 1.00 ch June 11. 1918

40 No trace. set ¼ cor.

60 Set 1/16 cor.

80 No trace of cor of 11.12.13 & 14 Set stake.

Thence South on same line bet 13 & 14
18. Gulch, W.
20 Set 1/16 cor & go to camp, June 12

40. Set stake - No trace of ¼ cor.
40.86 Pile of rock, bears W. 8 3 lks, may be old ¼ cor.
60 Set 1/16 cor.

80. No trace of cor of secs. 13.14.23 & 24

Thence South on same line
3.50 Temp cor of 13.14.23 & 24 set from west bears East 36 lks.
20 Set 1/16 cor.
41.92 ¼ cor. bears East 33 lks. a stone mkd ¼ in Md stone. Sept. 18. 1918.