Sec. 29 T. 2N R. 35E

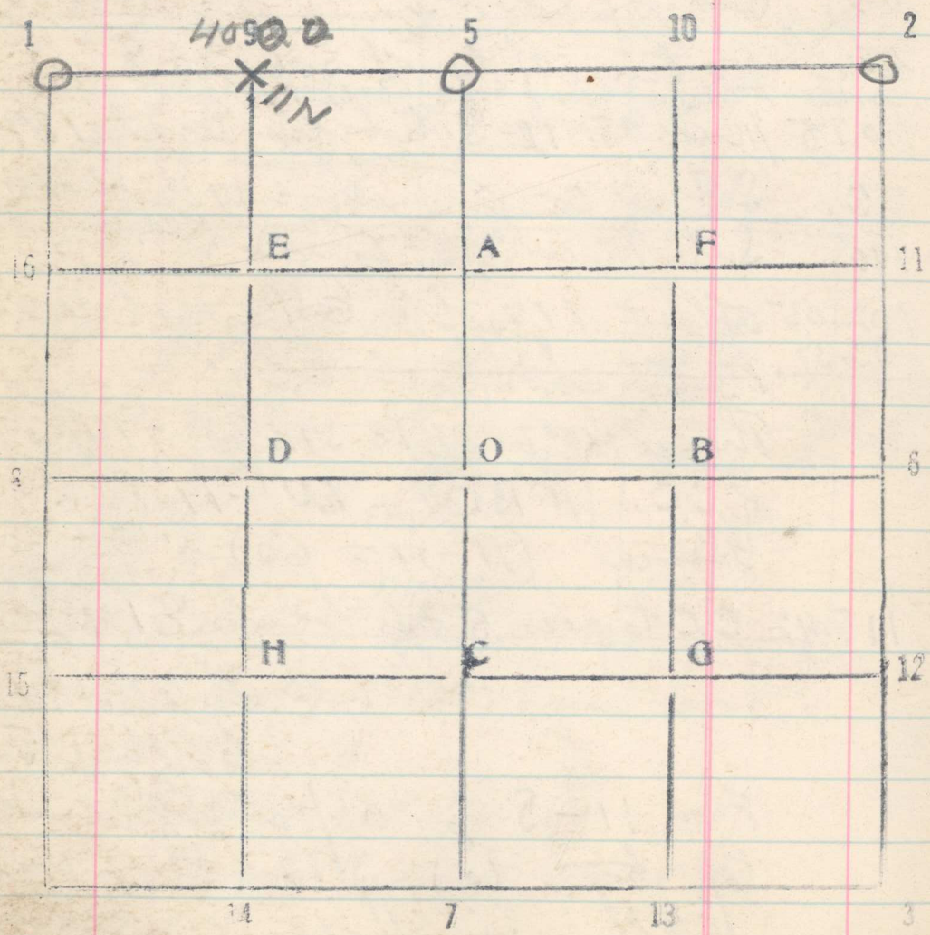

From 1/4 corbet 20 & 29 runs west
20 Set 1/16 cor
40. Cor of 19, 20, 29 & 30 bears
N. 22 lks. June 15, 1918