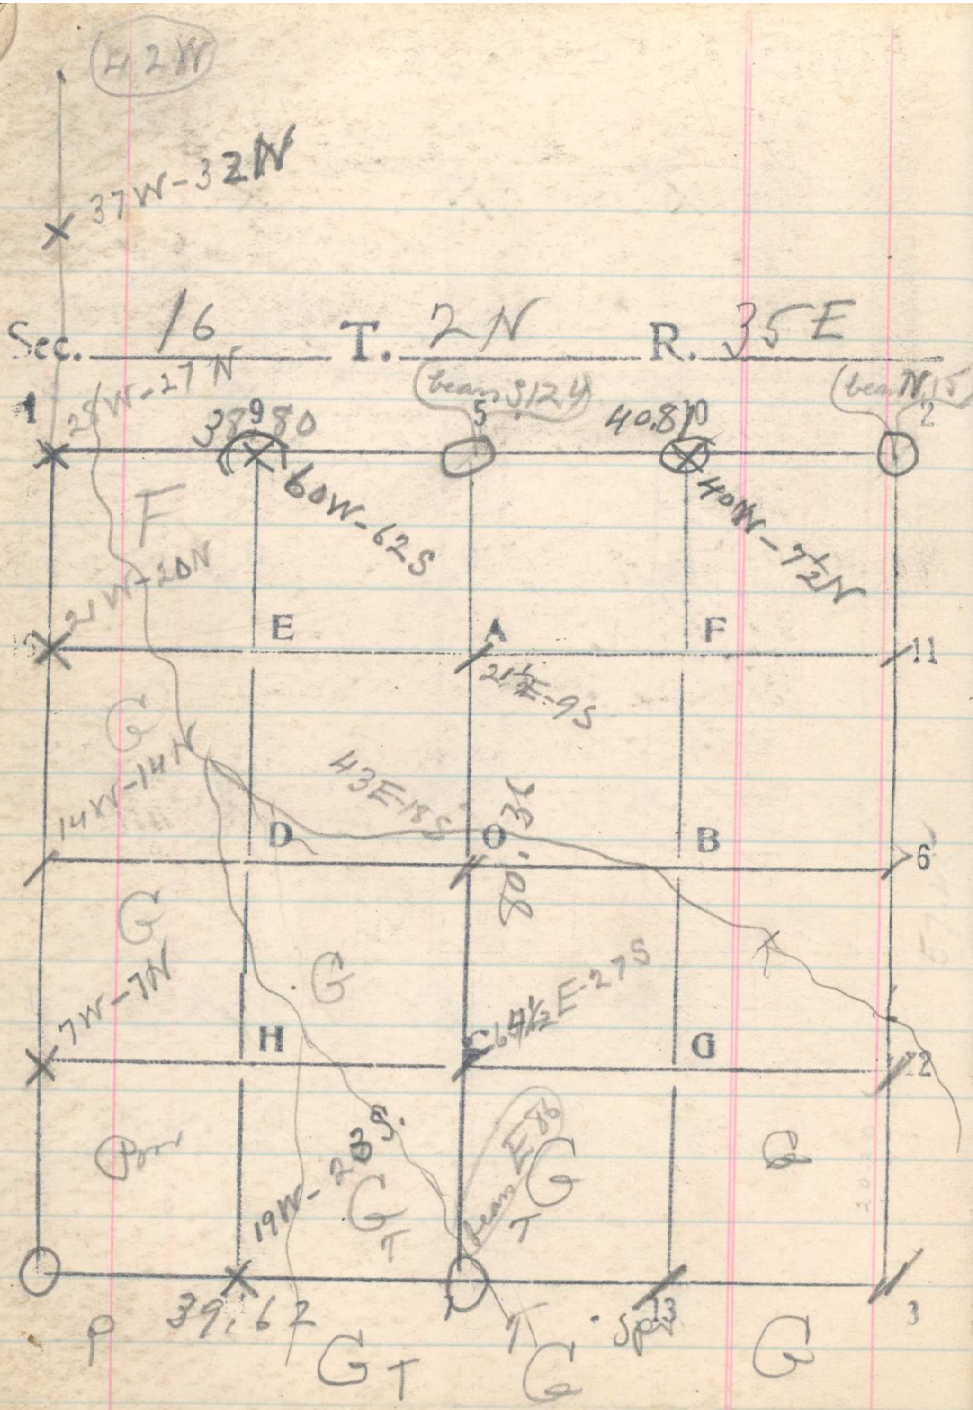

Aug. 10. East bet 16 & 21

20. Set 1/16 cor.

39.62 Pt. for 1/4 cor. located by B.T. bears S. 46 lks.

Tam 22 N 70° E 14 lk. mkd 1/4 S. PR BT

Tam 30 S 40° E. 43 lks mkd 1/4 S PR BT
(S 60° E in old notes)

Continue East on same line

20.00 Set 1/16 cor (or random 46 lks N of line with bearing)

40.00 N bank of Coal creek 15, 16, 21 & 22 Set stake
(100 ch. E of ridge alpine N.)

~~thence North bet 15 & 16~~

~~20. Set 1/16 cor. Stake at 57.45 from~~
~~N. bears N 62 1/2 E 5.72 chs.~~
~~N 3.50 E 4.53~~