


Sec. 21 T. 2 N R. 35 E,

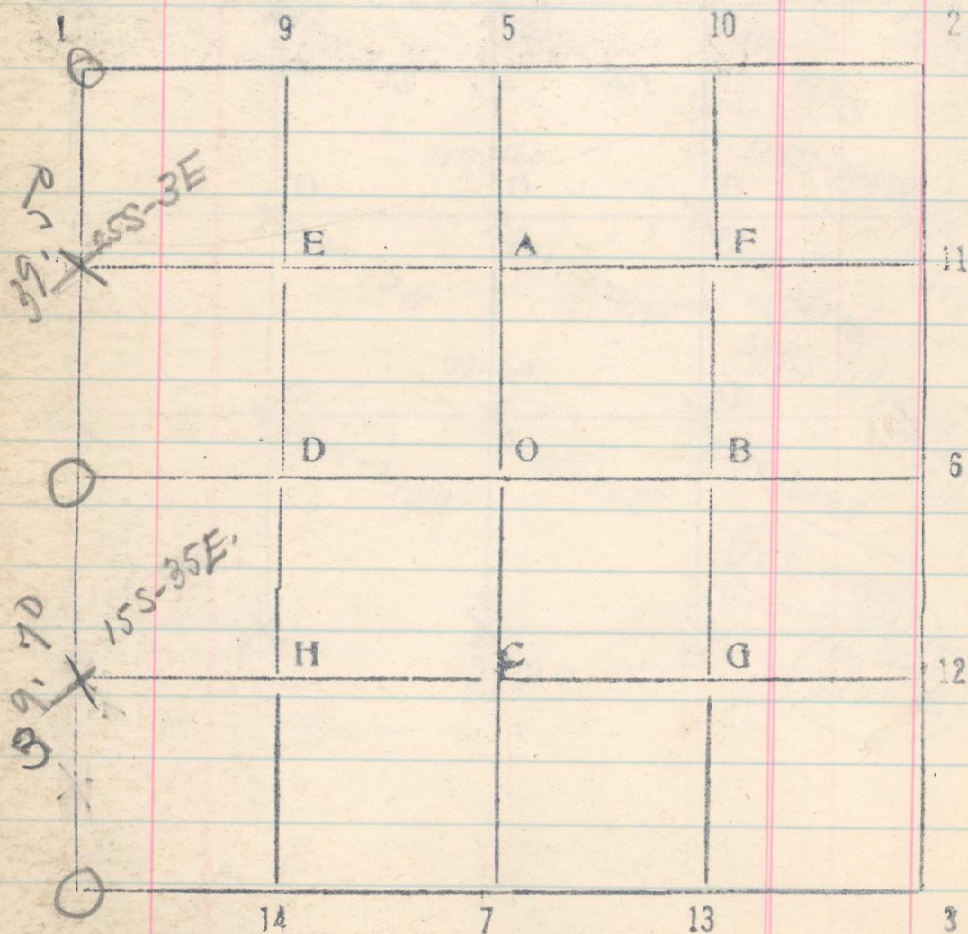

Aug. 26. N. bet 31 & 36 on W slope, ¹⁷²
 20 Set $\frac{1}{16}$ cov (at lower end of open slope
 to east, below ~~in~~ ^{returning})

39.70 $\frac{1}{4}$ cov bet 31 & 36, a stone in NW
 mhd $\frac{1}{2}$ on W face, bears E, 70 lks.

From open run North by BS on T¹ cov.

20 Set $\frac{1}{16}$

39.58 Cov of 25, 30, 31 & 36 bears E, 6 lks.