


Sec. 19 T. 2 N R. 35 E

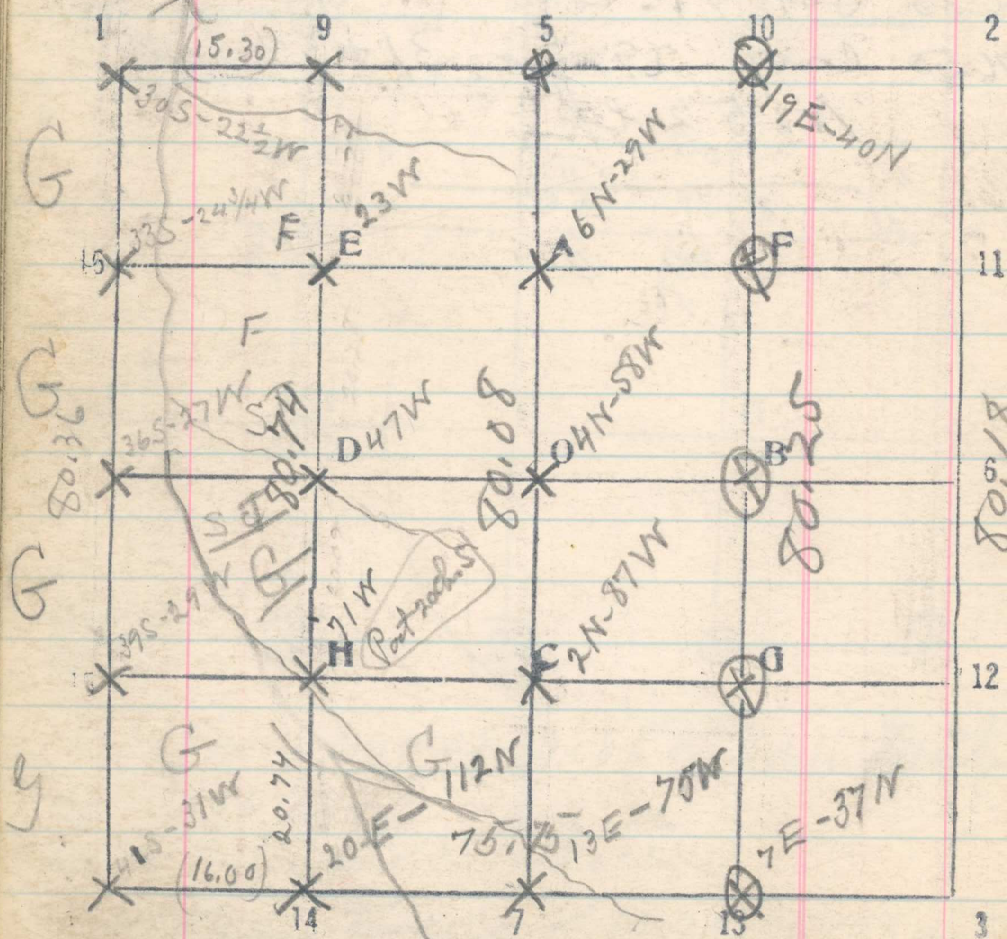

From temp cor of 18-18, 19 & 24 mm S.

20 Set 1/16 cor

- 40 Notation of 1/4 cor. set Stake 174
 60 Set 1/16 cor
 80 Notation of record of acres 19.24
 25 & 30 Set stake

From cor of 19.20. 29 & 30 mm West

- 20 Set 1/16 cor
 40 Notation of 1/4 cor Set 1/16 cor
 60 Set 1/16 cor
 75.75 Cor of 19.24. 25 & 30 bear N.
 14 3 lbs $\frac{143}{83}$
 110