


Sec. 7 T. 2 R. 35

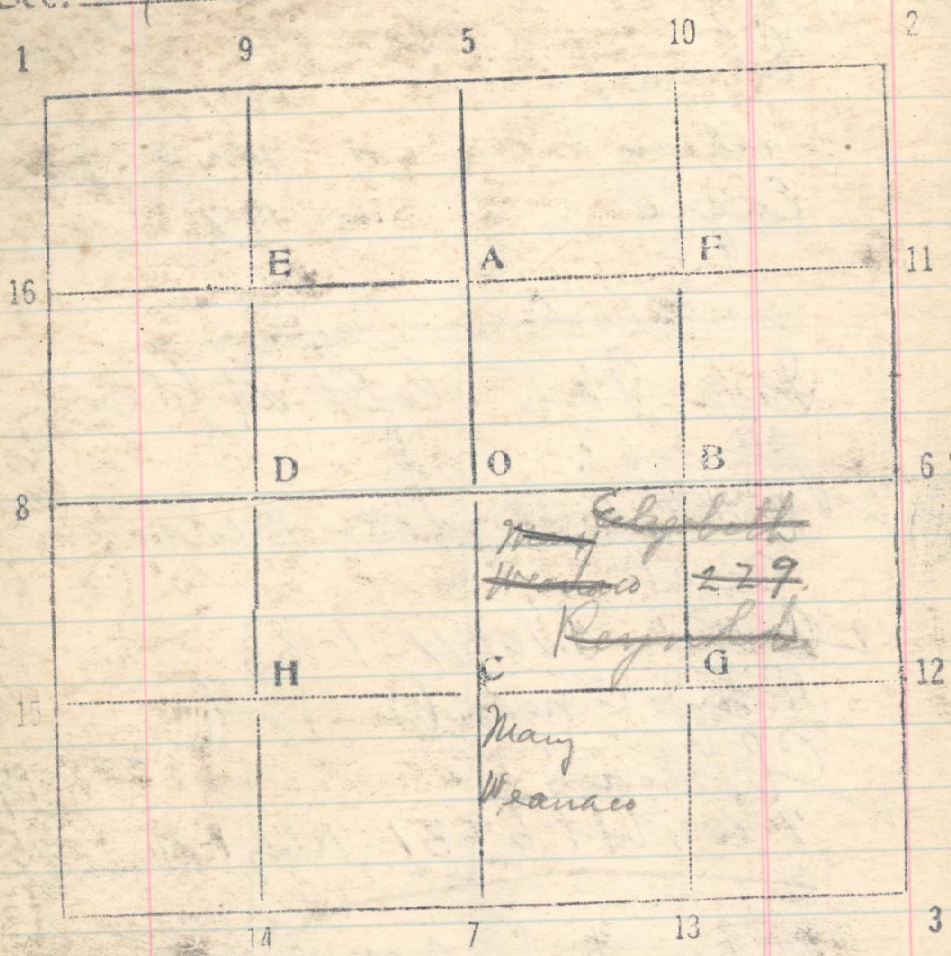

June 4. Weanaco claims SW 35 7-2-35 for Mary Weanaco. Says he was told Major he wanted it long time ago + Major said all right.

Raymond Adams. 14 years  
 Monday, Texas. 1/2 sold + then  
 April 8, 9, 10 + 11. 3 1/2 days 191  
 Violet Picard Huffman, with in Koffman  
 Kettle wants Peter Murray to select.

1/2 6/120 112 70 37.92.  
 20 145 10 54.0  
 24 5° 24'

4/120 4.2  
 30 173  
 66 3.27 78  
 2.23 2.50

66 in 100ft  
 33 in 50ft.

150 140 140 264 66 240  
 9 1.6 70 9 24 5  
 1350 1400 65 34 190  
 160 2100 50 35 170  
 1.95 110 108 38  
 5 108 118 33  
 445 150 126 114  
 15

Julia Kaleyton - Dick Johnson 233  
 died Friday swarburn Saturday