


12
Sec. 25 T. 2N R. 35E

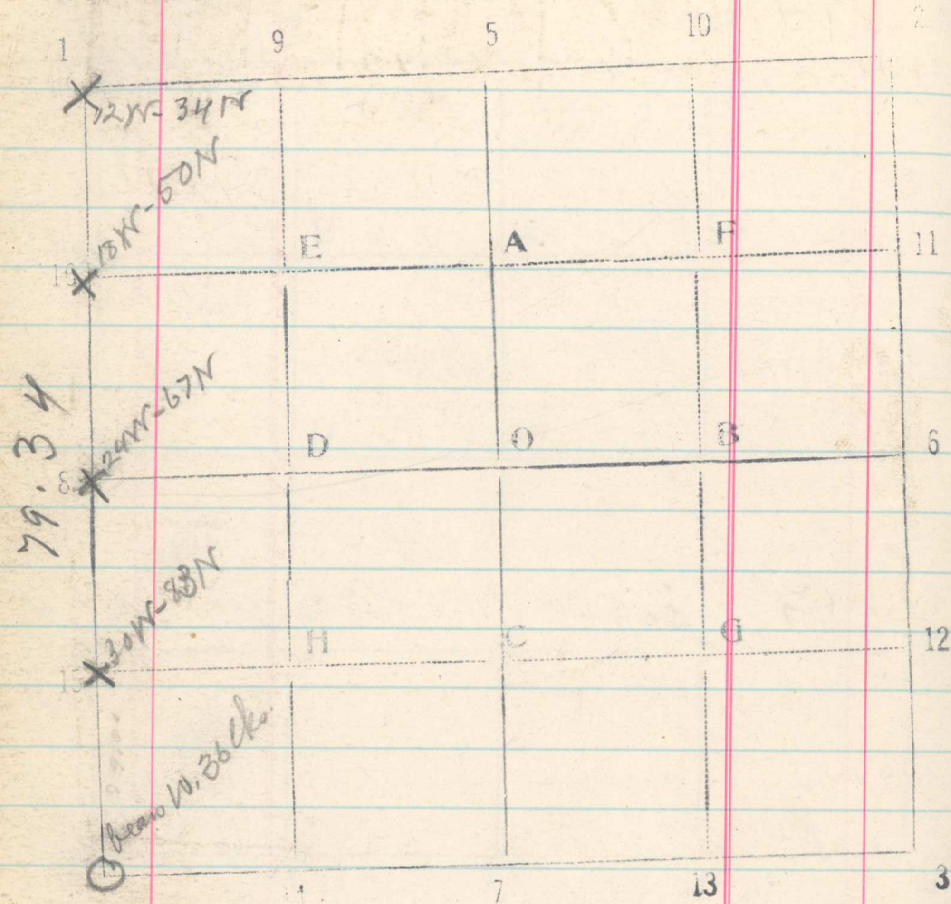

From trap cor of 23, 24, 25 + 26 run South
20. Set $\frac{1}{16}$
40 No trace of $\frac{1}{16}$ cor set stake
60 Set stake
79.00 Cor of 25, 26, 35 + 36 beam W. 36 lks.