Sec. 7 T. 2N R. 36 E

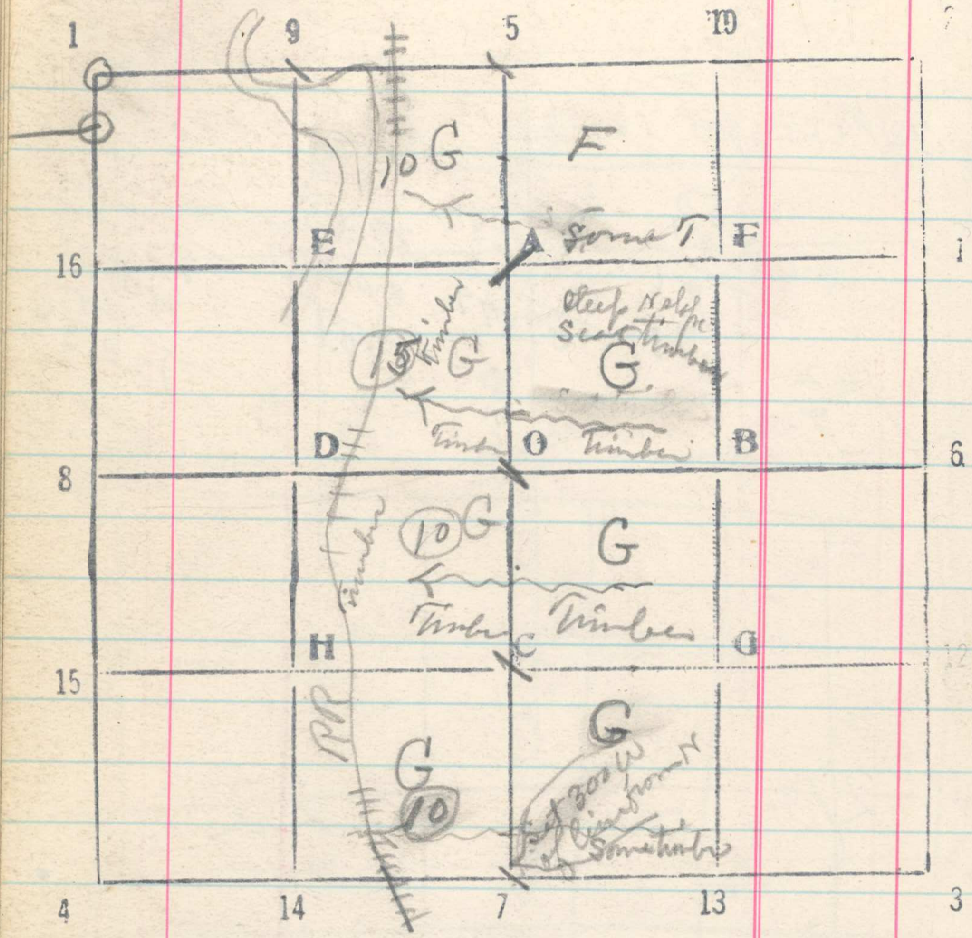

From temp 1/4 cor bet 6+7, set from N, run South on same line.

20. Set 1/4 A - S.7
40 Set 1/4 cor O - S.7
42.83 Bar East 5.00 Angle 21°4' Dist 13.00
55.83 To flag.
74.35 Mark dead Cherry 2 ind [illegible] go to camp
80.00 No trace of 1/4 cor bet 7+18. Set stake 300 lks W.

Dec 6 1918