


Sec. 35 T. 3 R. 34

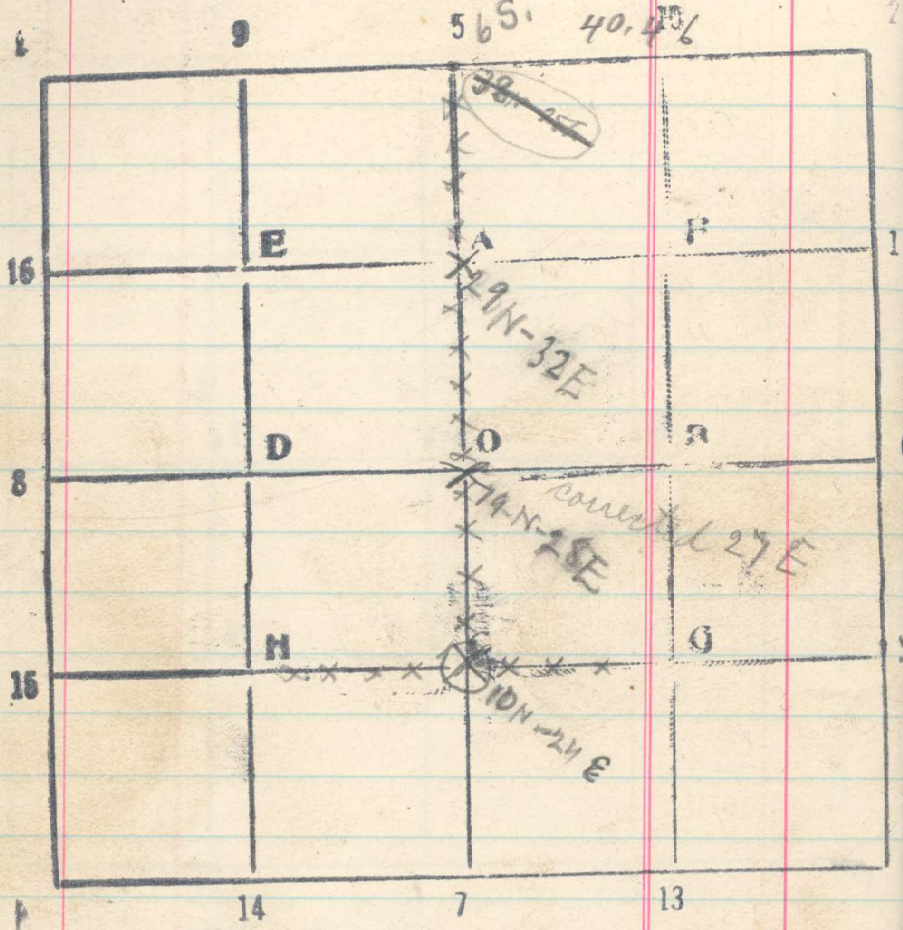

226