


Receipt for June

Ridgely	57	Garments, 2/10
Carter	33	
Quilman	68	
Page	81	
Banger	53	
	<u>342</u>	

Tom Lynch	77
Glenn	90
John	89
	17
	63
	62
SEM	50
	16
	<u>464</u>

Ment. Agency	17.00
" " Agency	9.00
Milk	1.00
Potatoes	1.90
Joe Cress	
(ex. button)	

Sec. \_\_\_\_\_ T. \_\_\_\_\_ R. \_\_\_\_\_

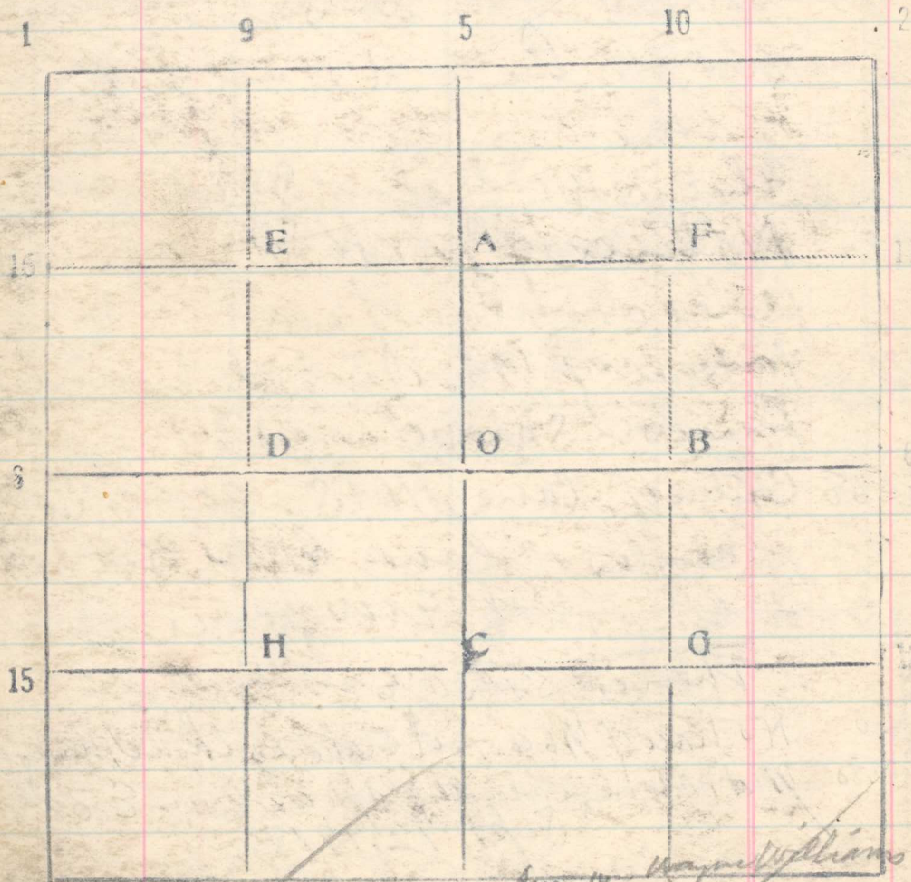

4	Am. Nat. Park	#10	7	Aug 14	Wayne Williams
	P. O. - 3/10	51		Aug 14	Edmund Picard + Thomas
	Electric light bill	1.		Aug 15	William Williams

Children of Adolph McKay 190

Elsie Farrow	1907
Lillian Anita	4 1914
Elycie	" 1917

Iron Post left at following places:

- |                                   |             |
|-----------------------------------|-------------|
| ✓ Mitchell Lloyd's on McKay Creek | No. Post 67 |
| ✓ Camp 2-3-10+11-1-33             | 7           |
| Tom Joe near Rim Rock             | 8           |
| ✓ Chadsays                        | 17          |
| 1/4 cor. btt 6+31-10 bdy + 34     | 5           |

~~Witnesses to Log Cabin Spring:~~  
~~Tom Joe, Amy Johnson, Joe Allen,~~  
~~Sol Webb, Harry Morse.~~  
 Expensive stumps. 1 tan. 1 for  
 about 1/2 mile near