Sec. 4 35 T. 8N R. 34E

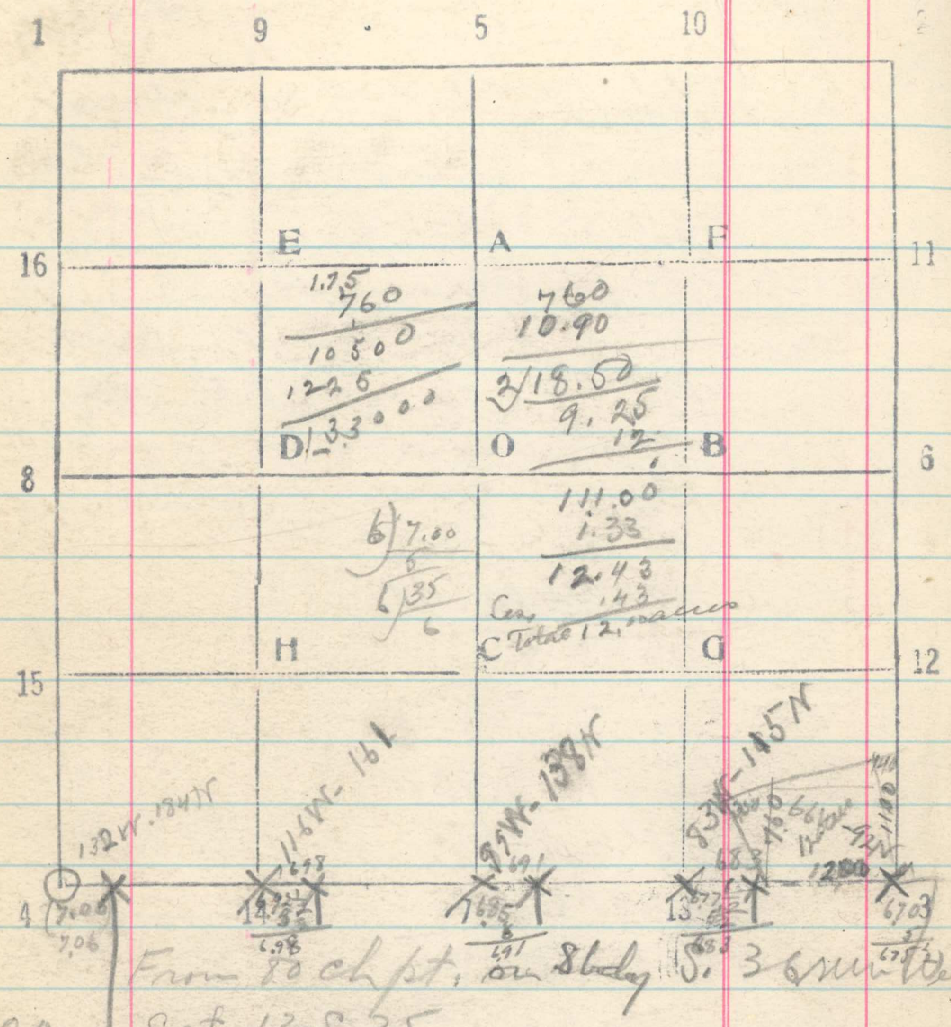

From Loch pt. on Shaley S. 3 6 sun West

20. Set 13-S. 35
33.30 Set ¼ cor for S. 32
40.00 No trace. Set ¼ cor for S. 35
53.30 Set 9-S. 2
55.00 ~~Set stake~~ rg. to comp Oct. 22
60.00 Set 14-S. 35
81.32 old cor of 35, 36 bears N. 18 E 40 dist
No stone property mkd in W.S.
Oct 24