Sec. 34 T. 2N R. 35E

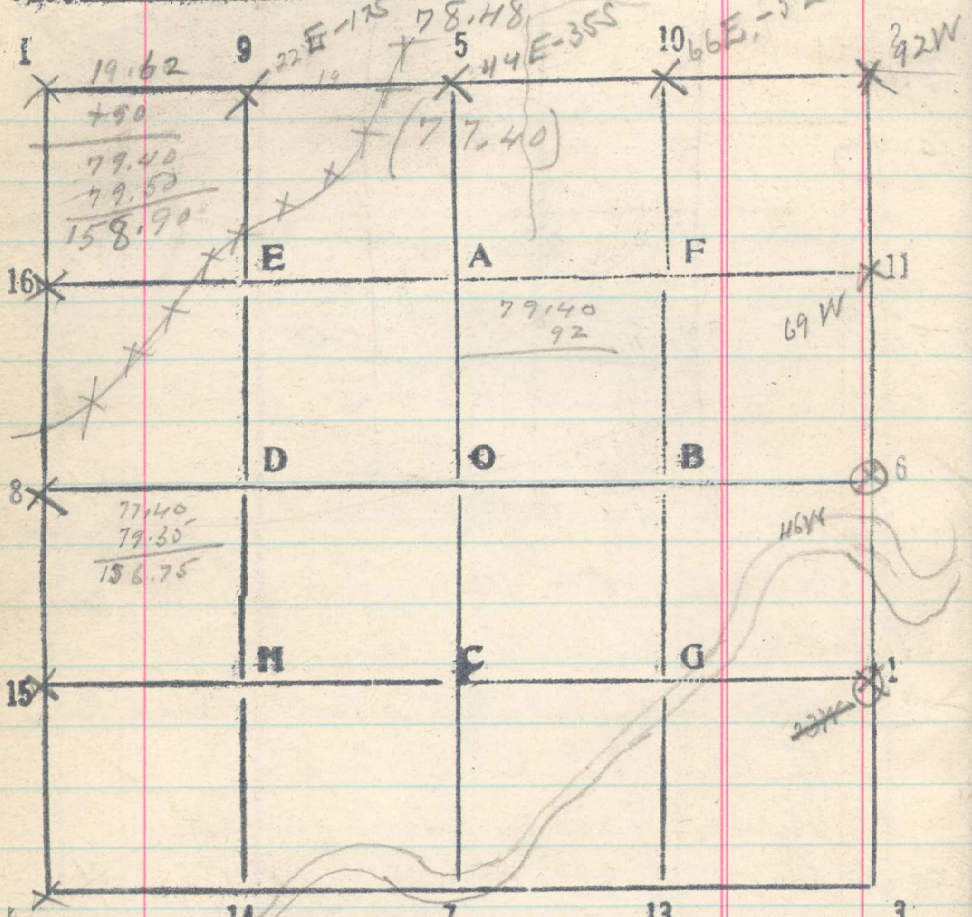

From ~~Corn~~ Cor of 27.28.33 + 34 run
Earthet 27+34

19.40 Set 1/16
(19.40)
39.80 Set 1/4 cor
(19.40)
58.20 Set 1/16
(19.40)
77.60
+1.80
79.40 Cor runs 26.27.34+35 bears S. 70 Ele

2/216
108
77.40
78.48
4/108
27
19.62
19.40
4
77.60
88
78.48

240.
77.60
.65
4
260
1940
19.67

158.90
156.75
2/2.15
108
79.35
180
92
88
1962
78.48

1' 79.35
77.40
156.75
15
.88E
.92
108
15
92

230