


Sec. 26 T. 3N R. 35E

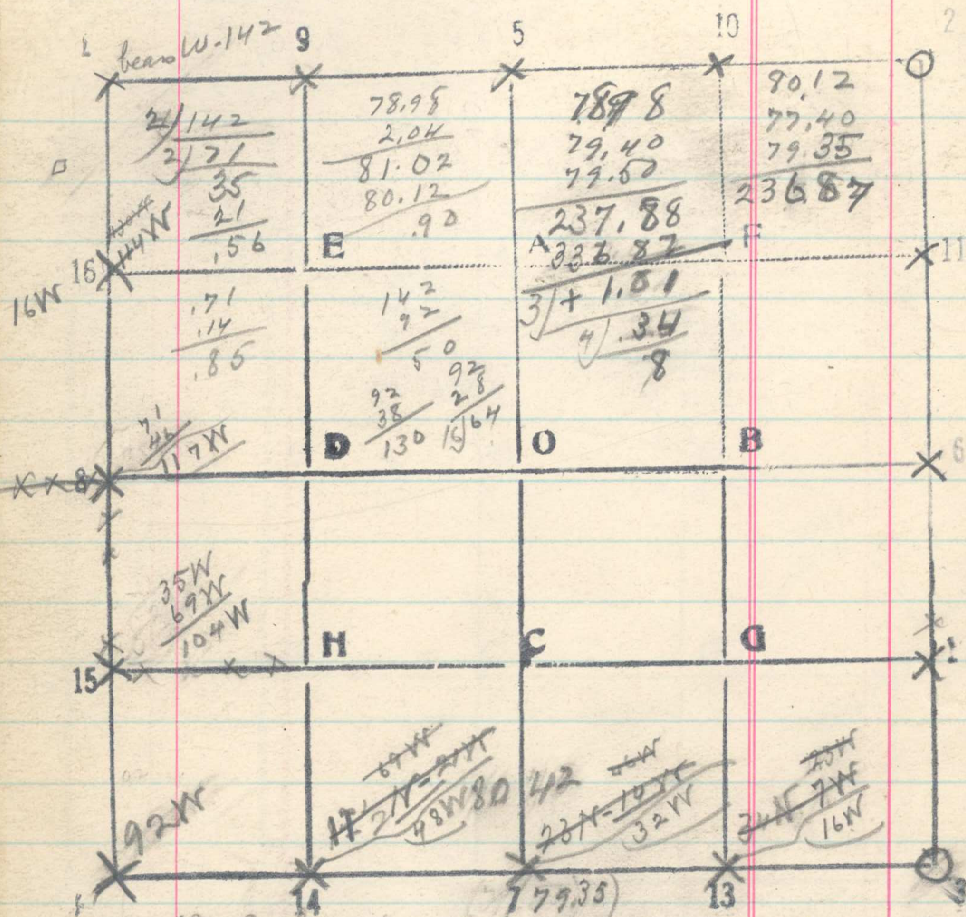

North bet 26 & 27 (7/8 right of 1/2 S on line 1-4 - Sec. 35)

- 20.20 Fence cor, N + E, bears W. 4 lks.
- 40.40 Fence cor, S + W, on line
- 80.80 Cor of secs 22, 23, 26 + 27 bears W 142 lks

East bet. 26 + 35

20  
40. ...  
Set 1/6  
Notion of ...

231

60 Set 1/6  
+ 92  
79.50  
(79.35)  
8042  
Cross sec 25, 26, 35 & 36 bears N. 46 lks  
May 29, 1919