


118 19.00
 17
 $\frac{1.45}{7}$
 1.38

Sec. 28 T. 3N R. 36E

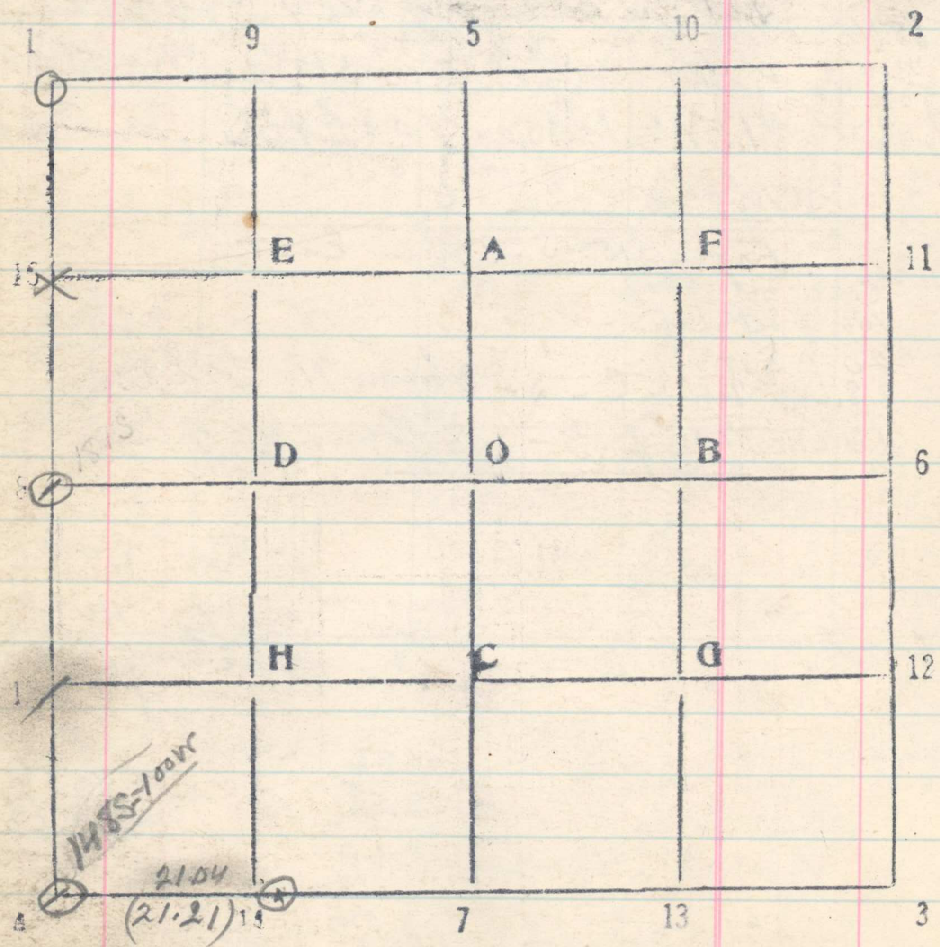

July 9 From top cor of 28. 29. 32 + 33 on N

7.46 Blaze by tree for B 3-Δ. Set flag ~~166~~ N
 go to flag on N side of gulch + run base E
 5. chs to pt. from which Δ bears S 19° 10'

Dist. 19.81 chs. + 7.46 =
 27.27 to flag.

140 No trace, set stake.

