9

Sec. 21 T. 3N R. 36E

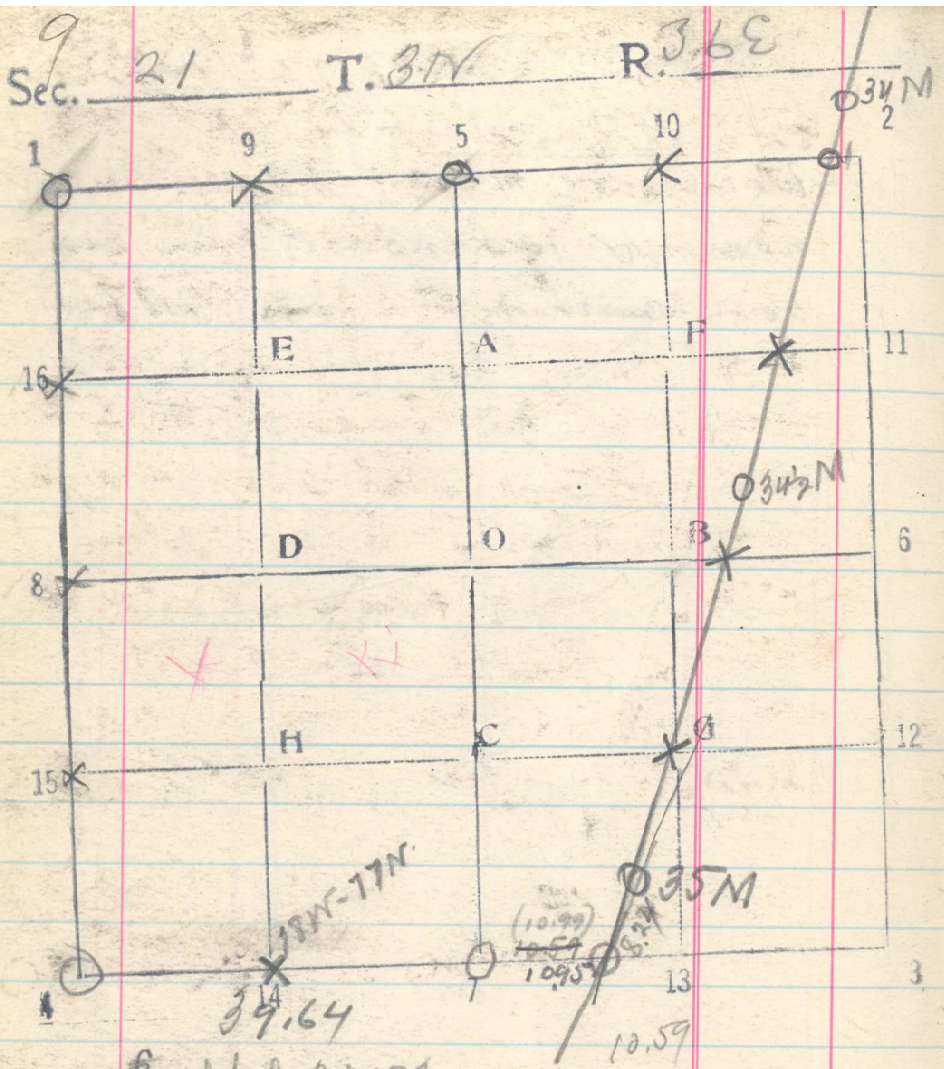

East bet 21 + 28

20 Set 1/16 cor

24.58 Umatilla River S 60° W

39.64 ~~1/4 cor bet 21 + 28 bears N. 58 lks.~~

~~This cor is a pine 14, marks all cut out. Pine 14 N 60° E 8 lks marks~~

~~nearly all cut out, but part of 1/4 and part of BT still visible.~~

~~Pine 16 S 58° W 27 lks. marks all all cut out on upper blaze. Lower blaze is overgrown about 3 ins, and when I uncover it I find that part of BT was cut out soon after tree was first marked. Evidently this corner was destroyed, as this corner is supposed to be a post, with 2 BTs as follows:~~

~~Pine 18 S 45° E 15 + Pine 12 N 20° W 15~~

~~The trees I find do not agree at all~~

39.64 Pt for 1/16 cor bet 21 + 28 bears N. 155 lks. Locate this by old bearing trees. Fir 10 North 18 lks. mkd 1/4 S. BT. Stump of fallen Pine 8 S 30° E 18 lks. mkd 1/4 S BT.

36
10.59
10.95

from 1/16 cor bet 21 + 28 I run East by BS on cor 4 C.C. of secs 21 + 28 bears ~~N. 100 lks.~~ South 25 lks. This cor is an iron post.

Pine 14 N 53° W 23 lks. Mkd UR CC BT

Decayed pine stump 12 ft high 24 ins diam bears S 7° W 13 lks. mkd UR CC balance of marks obliterated. Oct. 7. 1918.