


Sec. 3 T. 1 R. 33

Examiner Date 4/20 19

344

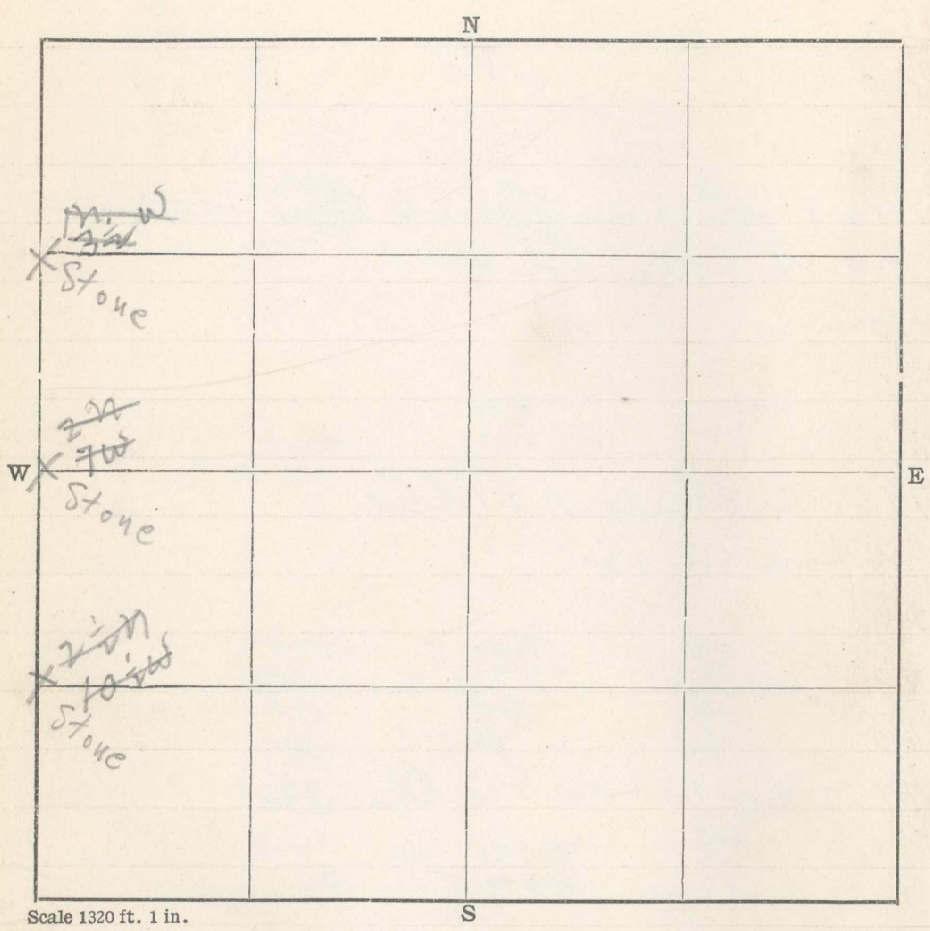

S from Cr 2

1760

3760

5760

7757 Cr 3 bears with ch