Sec. 13 T. 1 R. 33

Examiner ..... Date 4/24 19 18

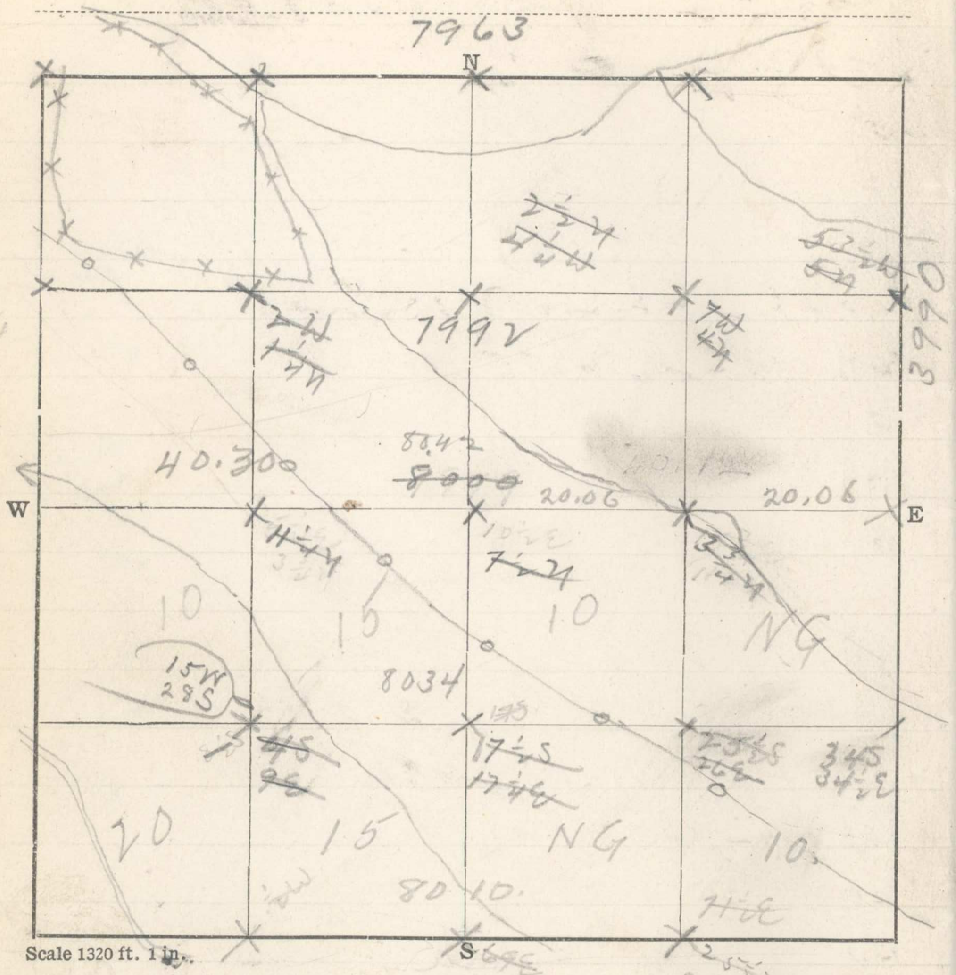

E from Cor 16

20

40

60

80 7992 Cor 1, bears N 5 lks

April 25, 1919. Find length of line 8-6 as above and find Cor. B, 33 lks. S. of line, Correct N,

From Cor 2 mm S

20

3990 Cor 6 bears W 107 lks 345

4/25 - W from Cor 6

20

40

60

8000 Cor 8 bears N 15 lks

4/26 - E from Cor 15

20

40

60

80

From Cor 6 mm S

1981 - 80 ch stake on line 15 - 11

4030 Cor 3 bears E 69 lks

W from Cor 3

20

40 No sign of ¼ Cor.

4/30 - E from Cor 4

20 turn ∠ 1° Rt. and find Cor 3 bears 10 lks S

Set 20 ch stake on line bet. Cors. 4 + 3 true mm E

3901 Stake 40 lks W of Cor 3 bears S 51 lks.

5/6 - Corrected cors. on S bdy. as to conform to mean by the regulation. Error in bearings