


Sec. 15 T. 1 N R. 33 E
 Examiner C. E. Redfield Date April 24 1919

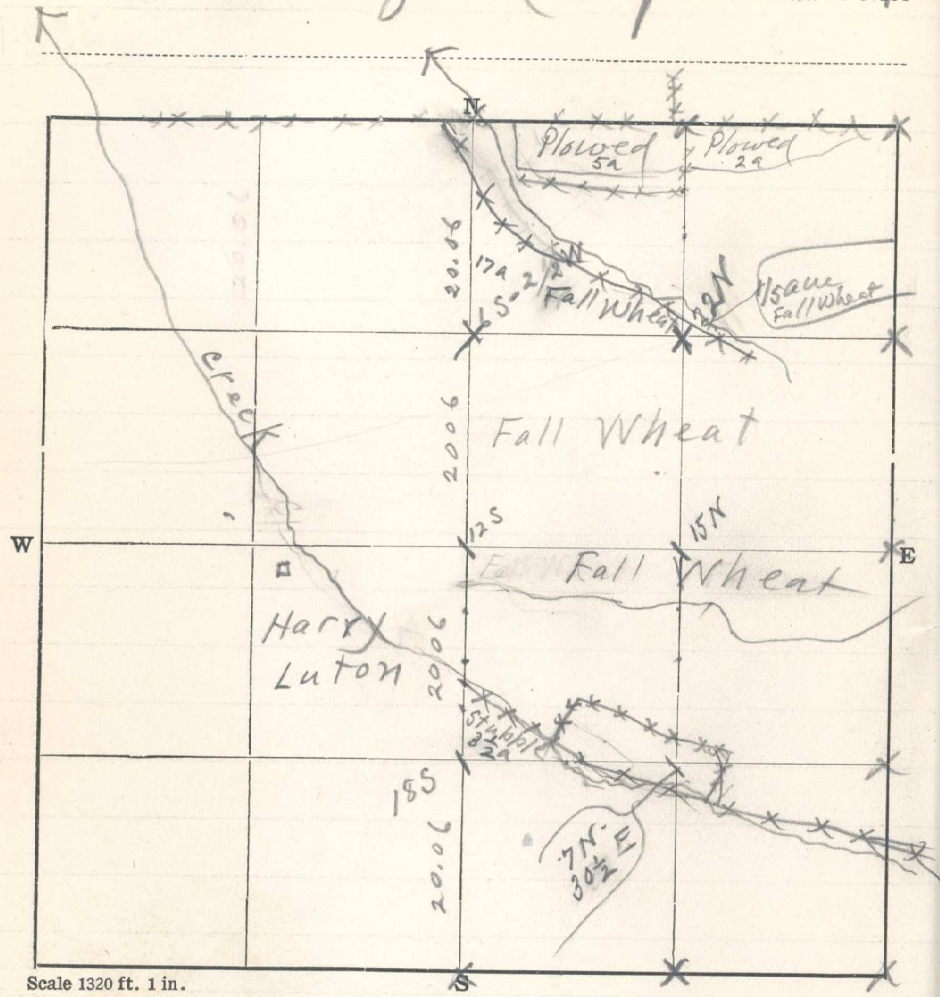

353