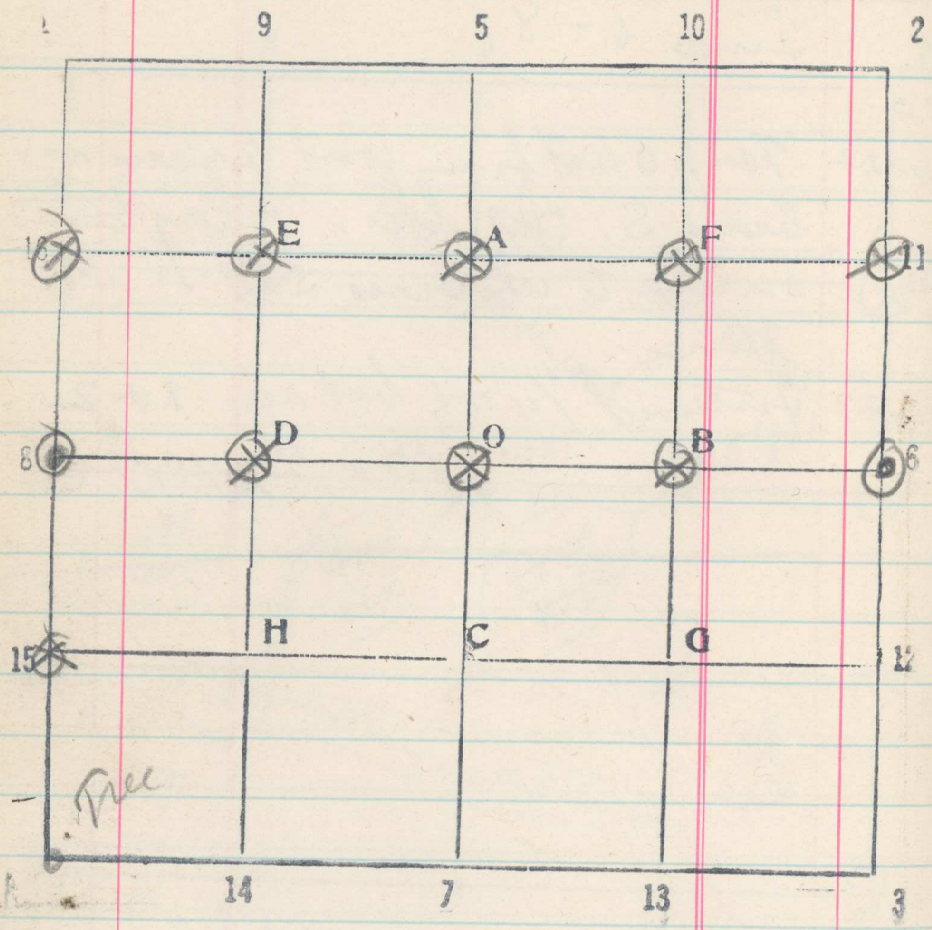Sec. 2 T. 1N R. 34E