


8

Sec. 3 T. 1N R. 34E

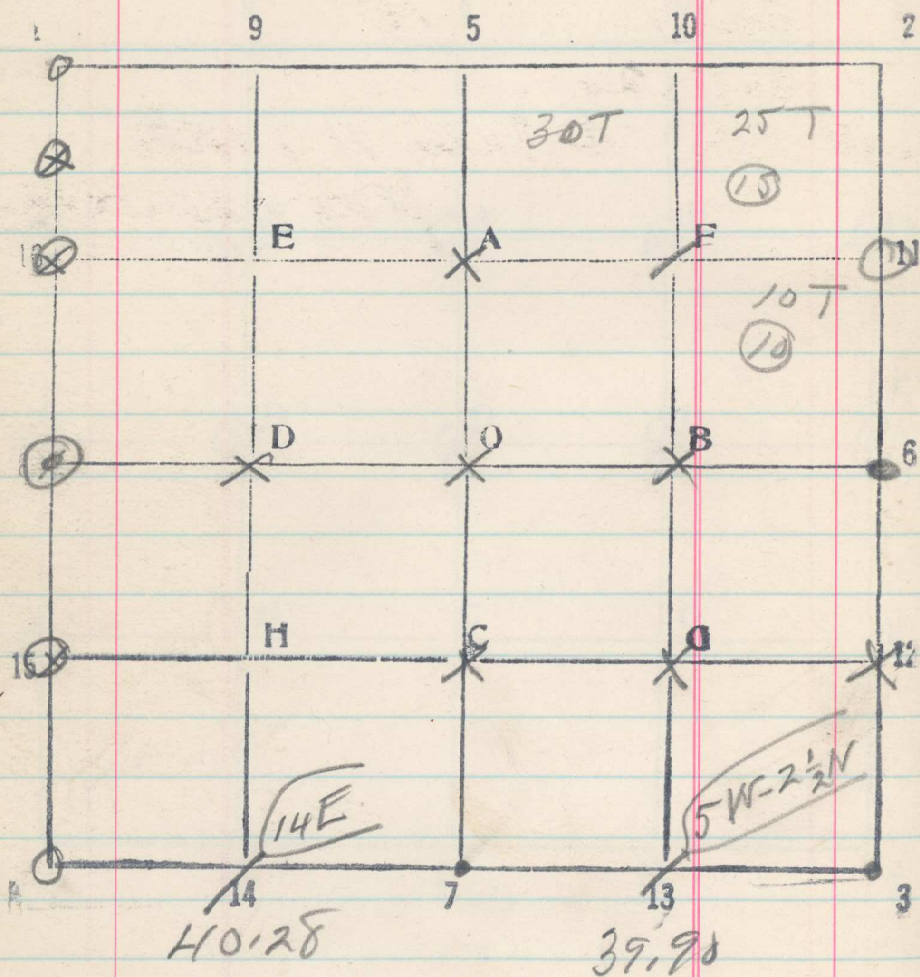

290

Line 11-A

Set 20

40.28

Cov A bears N. 16 lks.

Nov. 20, 1919