


2
Sec. 9 T. 1 N. R. 35 E

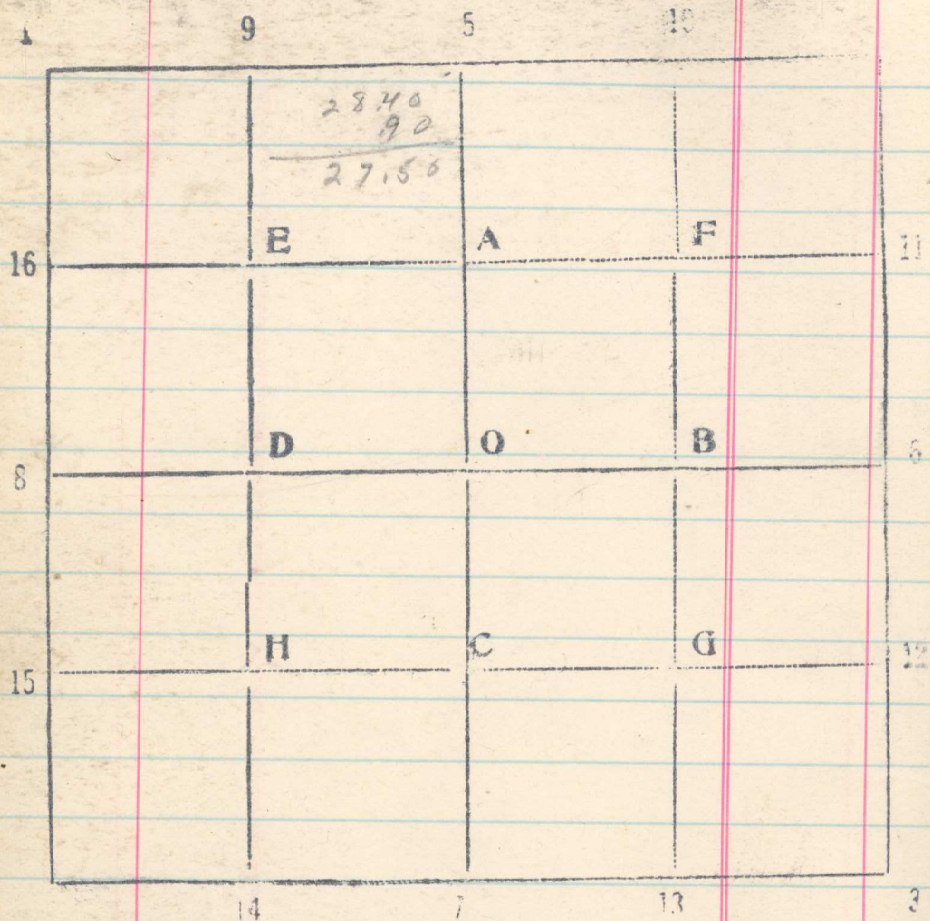

East bet 9 & 16.

2750 Flag - Dead pine stub about 40 ft high near fence
Base North 4.43 chs. to Big fir tree
Also set flag 57 chs S, making rock base

Henry Hicks, Almanac 1888
July 12, 3, 5, 7, 8, 9, 10, 11, 9 days @ 4, 30