


21
Sec. 2 T. 1 N R. 35 E

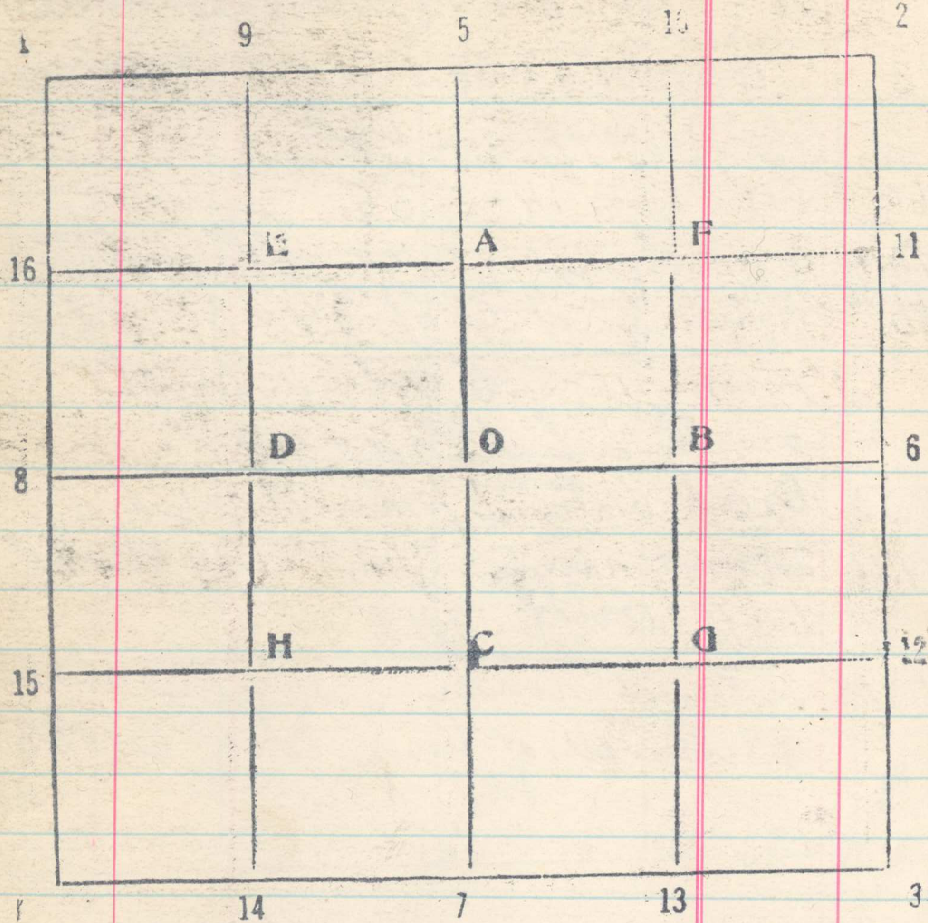

From temp Gov of 34 & 35 set
from N. run meandered
line as follows:

S 69 1/4° W 23.80
S 99 1/4° E 7.90
South 16.20
S 11° E. 7.93

East .89
S 27° E 5.00
S 44° E 5.00
N 61° E 14.00

N	S	E	W
	8.22		21.70
	7.79	1.34	
	16.20		
	32.21		256
	7.79	1.52	
	40.00	2.86	21.70
		.89	
	4.45	2.27	
	3.60	3.47	
		12.24	
	6.79		
	6.79	8.05	21.73
	6.79		21.70
	1.26		

To point 126 ch
S. of point for 1/4 cor bet 2 & 3